

Section 35 Township 12 Range 22 W

Well No. #1 U. S. Government

Company Central Commercial Co.

NORTH

	0						

WEST

EAST

SOUTH

Trago

KANSAS

SEC. 35	TWP. 12	R. 22W
---------	---------	--------

WELL NO. #4 U. S. Government

FARM

COMPANY

Central Commercial Co.

CONTRACTOR

Peel Bros.

Ogallah


_____ Ft. from N. Line

_____ Ft. from S. Line

_____ Ft. from E. Line

_____ Ft. from W. Line

NE NW NW

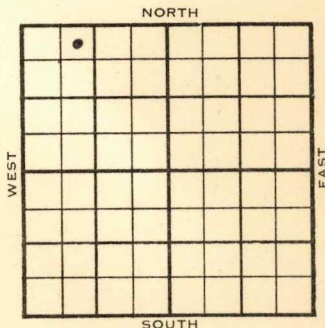

1955	ELEVATION 2331 DF 2334 KB	REPORT FIRST REPORT
------	---------------------------------	------------------------

8/10

Comm 8-4-55
8" @245/175 Drlg: 3115

9-21

DST 3988-4010 op 1 hr. rec. 2715' oil,
BHP 1140#;
5 1/2" @ 4012;
CO 4012;
PB TD; 19/3990-96; 10/3996 1/2-4002 1/2;
19/4006-12; fill 1000' oil no wtr.
8 hrs.

swb 10.53 boph no wtr.;
Phy. pmp 232 bopd no wtr.

Tops: Anh. 1735
 TP 3367
 H 3562
 L. 3599
 BKC 3835
 A 3988

T.D. 4013'

COMPLETED

County Trego Elev. _____
 Sec. 35 Twp. 12 Rge. 22W
 Company Central Commercial Co.
 Farm Name U.S. Government No. 4

TOPS	DEPTH	LOG	DATUM
Anh.			
TP.			
H.			
Tr.			
Dg.			
Bl.			
L.			
K.C.			
B.K.C.			
Ce.			
C.			
M.			
M.			
K.			
Mz.			
Mq.			
V.			
S.			
S.			
A			
R.			
PE.			
G.			
T.D.			

Loc. in Sec. NE NW NW
 Geol. _____
 Contr. Peel Bros.
 Pool Ogallah

0		

PIKSA REPORT
 AUG 10 '55

Date Comm. 8-4-55
8" @ 245/175 drlg.3115

5

Co.
 Lse.
 No.
 Sec.
 T.
 R.

2331 DF

County **Trego**

Elev. **2334 KB**

Sec. **35**

Twp. **12S**

Rge. **22W**

Company **Central Commerical Co.**

Farm Name **U. S. Government**

No. **4**

TOPS	DEPTH	LOG	DATUM
Anh.	1735		
TP.	3367		1033
H.	3562		1228
Tr.			
Dg.			
BL.			
L.	3599		1265
K.C.			
B.K.C.	3835		1501
Ce.			
C.			
M.			
M.			
K.			
Mz.			
Mq.			
V.			
S.			
S.	3988		1651
A.			
R.			
PE.			
G.			
TD.	4013		

Loc. in Sec.

NE NW NW

Geol.

Contr.

Peel Bros.

Pool

Ogallah

o		
COMPLETE		

Date Comm. **8-4-55**

SEP 21 1955

8" 245 w/175; DST 3988-4010 op 1 hr. rec.

2715' oil, BHP 1140#; 5 1/2" 4012; CO 4012;

PB TD; 19/3990-96; 19/3996 1/2-4002 1/2;

19/4006-12; fill 1000' oil no wtr. 8 hrs.;

swb 10.53 boph no wtr.; Phy. pmp 232 bopd no wtr.

Co.

Use.

No.

Sec.

T.

R.