

Map No. _____ Sec. 27 Twp. 33 R. 2E

Well No. 15 Levinson Farm

Amo Oil Company

11

WEST

EAST

SOUTH

Location _____

Drilling Remarks

Rig Up_____

Drilling Remarks

RECORD

Cased.....in.ft.

Sand -----

Gas -----

Oil _____

Total Depth.....

PRODUCTION

1st 24 hrs. Nat.

1st 24 hrs. after shot.....

Gas..... cu. ft.

Dry Hole.....

Abandoned

Map No. **KANSAS** Sec. **21** Twp. **33** R. **2 E**Well No. **1** **Guinn** Farm
Inno Oil Company

NORTH

210 Ft. from N. Line


_____ Ft. from S. Line

103.5 Ft. from E. Line

_____ Ft. from W. Line

WEST

EAST

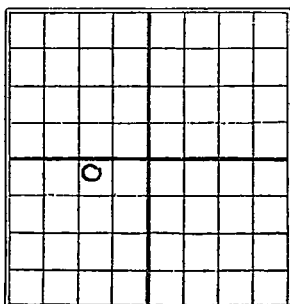

-SOUTH

1928

Date

REPORT

3/7	Pond
3/14	moving in rig
3/21	R.O.G.
3/28	Rig
4/4	Rigging up-
4/11	Spud
4/18	Drlg 830
4/25	" 1320
5/2	" 1850
5/9	" 2050
5/16	Sand 2325-76- H.F.W.
	T.D. 2394 - w.R. 8"
5/23	Drlg 2885-
5/31	T.D. 3275 - straight ream 6"
6/6	Chat 3280-3305 - shot 40qts
	3285-3305 - 5 bbls oil - 5 bbls
	water - T.D. 3310 - C.O.
6/13	H.F.W. 3550-70 - Shutdown
6/20	Drlg 3675 in sand-
6/27	No report.
7/3	T.D. 3710 H. & A.

Map No. **KANSAS** Sec. 21 Twp. 33 R. 27

Well No. 1 Quinn

Imo Oil Company

Contractor

SECTION PLAT

210 Ft. from N. Line

_____ Ft. from S. Line

1035 Ft. from E. Line

_____ Ft. from W. Line

	0		

FIRST REPORTS

Location _____

Rig up _____

Drilling and Remarks:

Pond

RECORD

Cased _____ in., _____ ft.

Sand _____

Gas _____

Oil _____

Total Depth _____

PRODUCTION

1st 24 hrs. Nat. _____

1st 24 hrs. after shot _____

Gas _____ Cu. Ft.

Dry Hole _____

Abandoned _____

Date

MAR 7 1928

S. J. LEWIS

Scout

K1
 Map No. **KANSAS** Sec. *24* Twp. *33* R. *2E*

Well No. *1 Quinn*

Imo Oil Company

Contractor

SECTION PLAT

210 Ft. from N. Line

_____ Ft. from S. Line

1035 Ft. from E. Line

_____ Ft. from W. Line

ABANDONED

	0		

Location _____

Rig up _____

Drilling and Remarks:

Total Depth

3710

J & H

RECORD

Cased _____ in., _____ ft.

Sand _____

Gas _____

Oil _____

Total Depth _____

PRODUCTION

1st 24 hrs. Nat. _____

1st 24 hrs. after shot _____

Gas _____ Cu. Ft.

Dry Hole _____

Abandoned _____

Date

JUL 3 1928

S. J. LEWIS Scout

Sumner

MAP NO. K1 KANSAS SEC. 4 TWP. 335 R. 2E

WELL No. 1 *Quinn*
Shirley Oil Co. COMPANY

CONTRACTOR

ABANDONED

SECTION PLAT

	0		

_____ FT. FROM N. LINE
 _____ FT. FROM S. LINE
 _____ FT. FROM E. LINE
 _____ FT. FROM W. LINE

RECORD

LOCATION _____

CASED _____ IN. _____ FT.

RIG UP _____

SAND _____

DRILLING AND REMARKS:

GAS _____

OIL _____

TOTAL DEPTH 3710

PRODUCTION

1ST 24 HRS. NAT. _____

1ST 24 HRS. AFTER SHOT _____

GAS _____ CU. FT.

DRY HOLE ☒ABANDONED ☒

DATE

7/11 1928 SCOUT