


Map No. Kansas Sec. 21 Twp. 33 R. 2E

Well No. 1 Rutter Farm _____
Refana Pet. Company _____

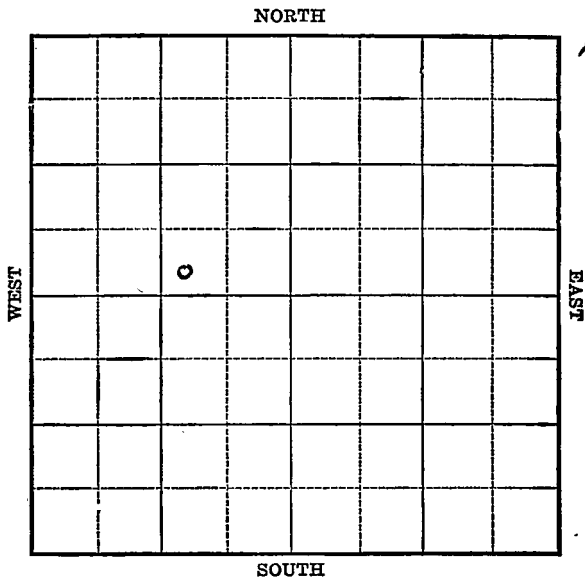

Location _____

Drilling Remarks:

RECORD

Cased _____ in. _____ ft.

Sand _____

Gas _____

Oil _____

Total Depth _____

Rig Up _____

Drilling Remarks:

PRODUCTION

1st 24 hrs. Nat. _____

1st 24 hrs. after shot _____

Gas _____ cu. ft.

Dry Hole _____

Abandoned _____

Map No. Kansas Sec. 21 Twp. 33 R. 2 E

Well No. 1 Rutter Farm


Rocana Peck Company

_____ Ft. from N. Line

300 Ft. from S. Line

1020 Ft. from E. Line

_____ Ft. from W. Line

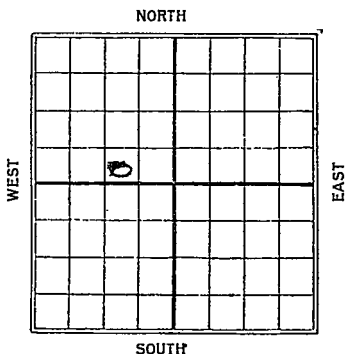

Beneal

Date	REPORT
<u>1925</u>	
<u>4/23</u>	<u>R. O. G.</u>
<u>6/5</u>	<u>Nly @ 2130</u>
<u>7/22</u>	<u>2890</u>
<u>7/29</u>	<u>L. Q. L. 3085'</u>
<u>8/7</u>	<u>3147'</u>
<u>8/14</u>	<u>3262'</u>
<u>8/19</u>	<u>Tap L. 3273 Oil 3200'</u> <u>T.D. 3305-15 bbls. S.D.</u>
	<u>for orders</u>
<u>8/27</u>	<u>T.D. 3305 Hole full</u> <u>Oil waiting for orders</u>
<u>9/2</u>	_____
<u>9/9</u>	<u>T.D. 3305 S.D.</u>
<u>9/30</u>	<u>✓ ✓ ✓</u>
<u>10/6</u>	<u>✓ ✓ ✓</u>
<u>10/13</u>	_____
<u>10/21</u>	_____
<u>10/28</u>	_____
<u>11/4</u>	_____
<u>11/11</u>	_____

11/8 same
1926

4/14 - _____

4/21 - _____

4/29 - _____

5/5 - same.

5/11 - top line 3432' T.D. 3480'
wildcat dry.

5/26 - T.D. 3618 waiting on orders

6/2 - T.D. 3621 Plugging back to
3350

6/9 - Plugging back to 3350

6/16 - " " " "
making 30 barrels

6/23 - getting ready to shoot

6/30 - shot 40 quarts 3297-3315'
swab 130 bbls.

7/14 - same

7/21 - Top Line: 3273

Oil 3300 T.D. 3315

30 bbls . 40 gts

60 bbls

Map No. **KANSAS** Sec. 21 Twp. 33 R. 2 ^{1E}

Well No. 1 Rutter

Royana Pet. Company

Contractor

FIRST REPORT

SECTION PLAT

----- Ft. from N. Line

300 Ft. from S. Line

1020 Ft. from E. Line

----- Ft. from W. Line

	0		

Location -----

Rig up -----

Drilling and Remarks:

R.O.G.

RECORD

Cased ----- in., ----- ft.

Sand -----

Gas -----

Oil -----

Total Depth -----

PRODUCTION

1st 24 hrs. Nat. -----

1st 24 hrs. after shot -----

Gas ----- Cu-Ft.

Dry Hole -----

Abandoned -----

Date

APR 23 1925

192

M. A. BENEAR

Scout

K1
Map No. **KANSAS** Sec. *21* Twp. *33* R. *27*

Well No. *1 Rutter*

Roxana Pet & Coke Company

Contractor

SECTION PLAT

	0		

----- Ft. from N. Line

300 Ft. from S. Line

1020 Ft. from E. Line

----- Ft. from W. Line

COMPLETED

Location -----

Rig: up -----

Drilling and Remarks:

Top Line E 3273
Oil 3300
TI 3315
30 x 4 1/2 Na Y
Blow 40 gpts
3297-3315
60 x 4 1/2

RECORD

Cased ----- in., ----- ft.
Sand -----
Gas -----
Oil -----
Total Depth -----

PRODUCTION

1st 24 hrs. Nat. -----
1st 24 hrs. after shot -----
Gas ----- Cu. Ft.
Dry Hole -----
Abandoned -----

Date

JUL 21 1926

S. J. LEWIS Scout