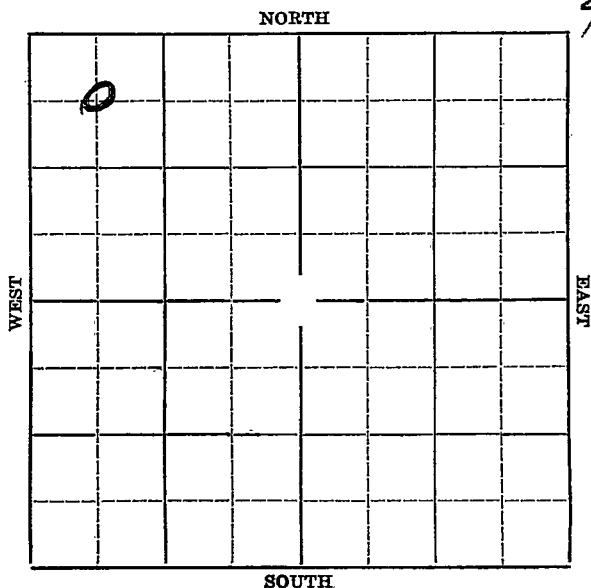


Section 21 Township 33 Range 2-EWell Number #1 RutterCompany Rose Spring

KANSAS


Map No. _____ Sec. 21 Twp. 33 R. 2EWell No. #1 Rutter ~ _____ Farm __________ Rose Spring _____ Company _____660' Ft. from N. Line

_____ Ft. from S. Line

_____ Ft. from E. Line

660' Ft. from W. Line

Elev. 1135

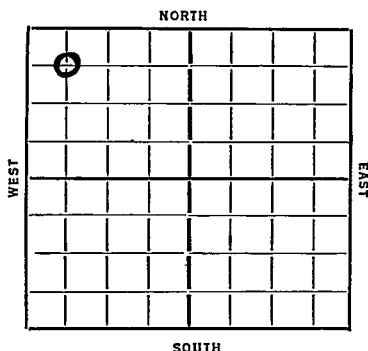Date
1936

REPORT

8/12 Rotary rig.8/20 Spud 60'.8/27 --9/3 Shut down.9/10--9/18--9/24-- 10/1--10/8--10/15--10/22--10/29--11/6 Drlg. 33811/12 Drlg. 203511/19 Drlg. 2900'.11/27 Chat 3215'. 7" @ 3225'. Rust.12/3---12/10--12/17 Oil 3222'. T. D. 3229'.

Hole full oil. Rig burned.

12/24 Flowed 75 bbls. 12 hrs.12/29 Pot. 126 bbls. Drilled to
3238' H. F. W.

P. B. 3235'.

19371/7 Shut down 3235'.1/14 Estimated 100 bbls. and some
water.

OVER

1937

1/21 Pump 127 oil 25 water 24 hrs.

1/28 Shut down.

2/4 " "

2/11 " "

2/18 " "

2/24 Chat 3215'.

T. D. 3238'.

P. B. 3233'.

Estimated 125 oil & 60 water.

COMPLETED

Samuel
Map No. 1 Sec. 21 Twp. 23 R. 24

Well No. 1 Rutter

Ross Spring Company

Contractor

SECTION PLAT

0			

660 Ft. from N. Line

 Ft. from S. Line

 Ft. from E. Line

660 Ft. from W. Line

FIRST REPORT

Location

Rig up

Drilling and Remarks:

Rotary Rig

RECORD

Cased in., ft.

Sand

Gas

Oil

Total Depth

PRODUCTION

1st 24 hrs. Nat.

1st 24 hrs. after shot

Gas Cu. Ft.

Dry Hole

Abandoned

Date

AUG 12 1936 19 S. J. LEWIS Scout

KANSAS

Form 26-1M Bks. 2-29

Map No. 1 Sec. 21 Twp. 33 R. 27

Well No. 1 Rutter

Rose Spring & Co. Company

Contractor

SECTION PLAT

0			

660 Ft. from N. Line

_____ Ft. from S. Line

_____ Ft. from E. Line

660 Ft. from W. Line

COMPLETED

Location _____

Rig up _____

Drilling and Remarks:

Chat 3215

P.B 3233

Estimated 1250

60 water

RECORD

Cased _____ in., _____ ft.

Sand _____

Gas _____

Oil _____

Total Depth 3238

PRODUCTION

1st 24 hrs. Nat. _____

1st 24 hrs. after shot _____

Gas _____ Cu. Ft.

Dry Hole _____

Abandoned _____

Date

FEB 24 1937₁₉

S. J. LEWIS

Scout