


Section 36 Township 12 Range 22W

Well No. #6 Kellogg- Wynn

Company Texas Co.

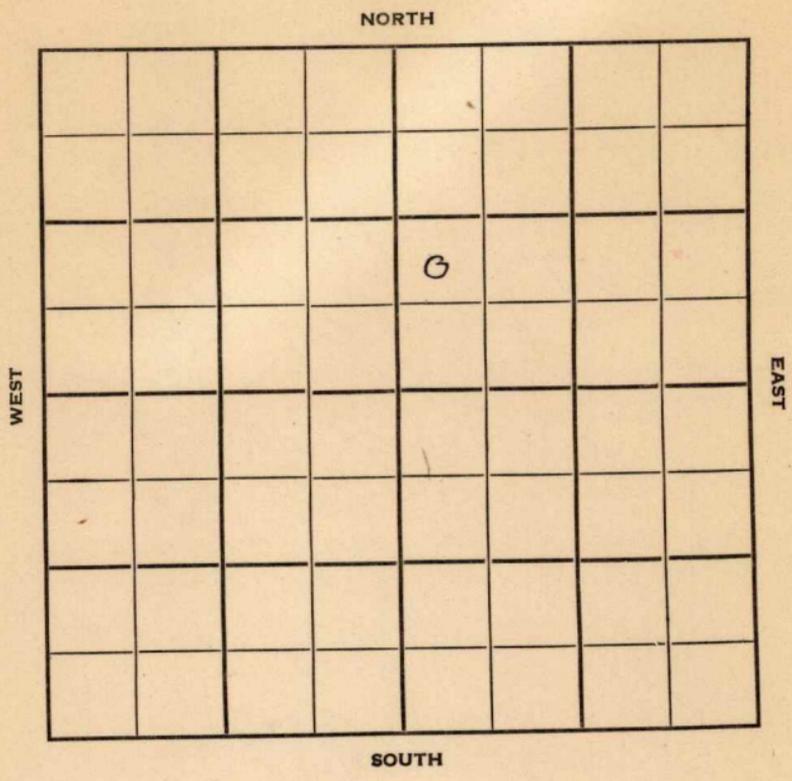

Trego

KANSAS

Sec. 36 Twp. 12 R. 22W

Well No. #6 Kellogg - Wynn Farm

Texas Company Company

Contractor


Ft. from N. Line

990 Ft. from S. Line

Ft. from E. Line

330 Ft. from W. Line

NE 1/4 NW SW NE

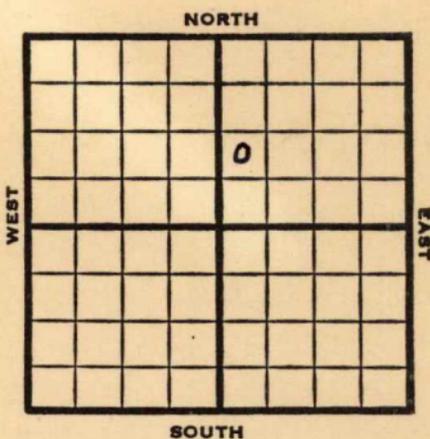

1952 Elev. 2328' REPORT

- 11/5 Spud 10-29-52
10" @ 228
Drlg. 2880'
- 11/12 Topeka 3362 Heeb. 3563
Lans. 3596 Arb. 3977
TD 4016 Schl.
- 11/20 7" @ 3980 RUST
- 11/27 B KC 3834, Simp 3962
CO 4016, S/8 BO 4 hrs., 500A
1 1/2 BOPH Hyd. 1000A, S/4 BO +
11 bwph PB 4003
- 12/4 S/16 BO / 92 BW 6 Hrs PB 4000
- 12/11 S/24 BO / 97 BW 12Hrs. PB 3991
SO&W PB 3987
- 12/18 300A S/1 BO / 10 BWPH Sq open hole
003983 S/13/4 BO / 3 3/4 BWPH 7 Hrs.
004010 FU 1200' Fluid
- 12/25 " " " "
- 1/1 DD 4030 TD 2 BO / 3 1/2 BWPH 5 hrs.
- 1/8 NR
- 1/22 NR

OVER

#6 Kellogg-Wynn

1953
1/28

Spud 10-29-52

Oil Well

TD 4030

10" @ 228

Top 3362, Heeb 3563, Lans 3596,
Arb. 3977

TD 4016

7" @ 3980

B KC 3834, Simp. 3962,

CO to 4016 S/8 bo 4 hrs. 500A

1½ boph Hydro. 1000A S/4 bo

11 bwph PB 4003

S/16 bo 92 bw 6 hrs.

PB 4000

S/24 bo 97 bw 12 hrs.

PB 3991, 2.6 go 11 gwph

PB 3987, 300A

S/1 bo 10 bwph

CO to 3983

B/1 ¾ bo 3 ¼ bwph 7 rhs.

CO to 4010

FU 1200' fluid

CO to 4016

S/2 bo 2 bwph 5 hrs.

Comp. 31 bopd 68% wtr.

COMPLETED

