


Trego

Section 36 Township 12 Range 22W

Well No. #3 Monroe

Company Stanoline Oil and Gas Company

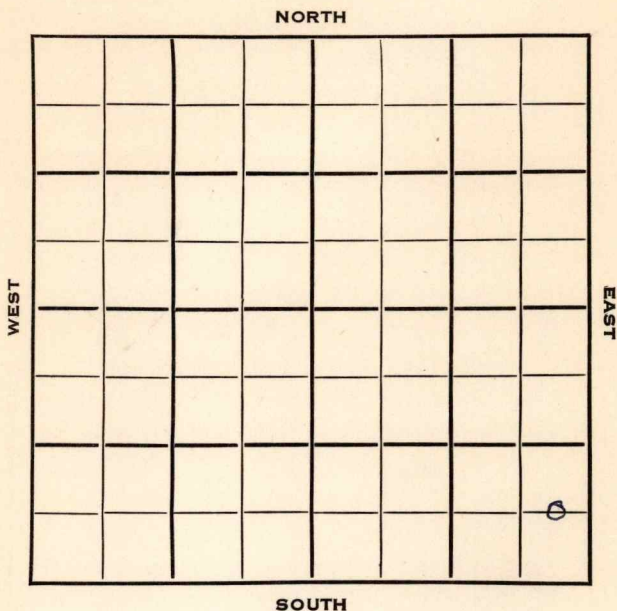

Trego

KANSAS ✓

Sec. 36 Twp. 12 R. 22W

Well No. #3 Monroe Farm

Stanolind Company

Contractor


Ft. from N. Line

660 Ft. from S. Line

330 Ft. from E. Line

Ft. from W. Line

C EL SE SE

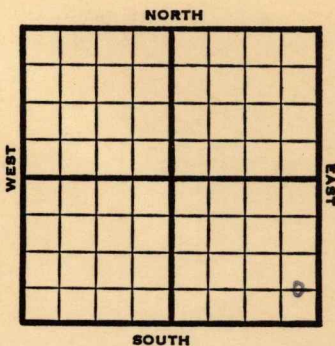

1953 Elev. 2268' REPORT

- 1/28 Location
- 2/5 "
- 2/12 8" @ 202  
Drlg. 2735'
- 2/19 Heeb 3525' Lans 3560 B KC 3794  
Arb. 3937  
DST 3934-44', 1/2 hr, 7' M  
Drilling
- 2/26 RTD 3974'  
DST 3950-59, 1/2 hr, 20' M plus SSO  
105#  
DST 3955-64, 1/2 hr, 5' HOCM, 25'  
SOCM 1000#  
DST 3959-74, 1/2 hr, 180' HOCM,  
1025# 5" @ 3959'
- 3/12 NR

OVER

#3 Monroe

1953  
3/18

Spud 2-4-53

D&A

TD 3974

8" @ 202

Heeb 3525, Lans 3560, B KC  
3794, Arb 3955

DST 3934-44, opn  $\frac{1}{2}$  hr., rec.  
7' mud,

TD 3974

DST 3950-59, opn  $\frac{1}{2}$  hr., rec.  
20' mud, &SS0, 105#

DST 3955-64, opn  $\frac{1}{2}$  hrs., rec.  
5' hocm, 25' socm, 1000#

DST 3959-74, opn  $\frac{1}{2}$  hrs., rec.  
180' hocm, 1025#,

5" @ 3959 pipe caved.

D&A

**ABANDONED**



