


Section 1 Township 12 Range 23 W

Well No. #1 E. Rinker

Company Transit Corp.

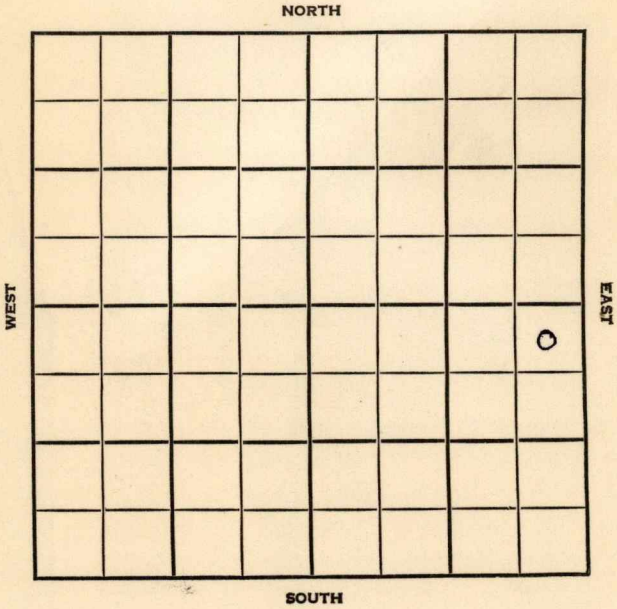

Trego

KANSAS


SEC.	TWP.	R.
1	12	23W

WELL NO. #1 E. Rinker FARM

COMPANY Transit Corp.

CONTRACTOR Co. Tools
Wildcat

_____ Ft. from N. Line
 _____ Ft. from S. Line
 _____ Ft. from E. Line
 _____ Ft. from W. Line

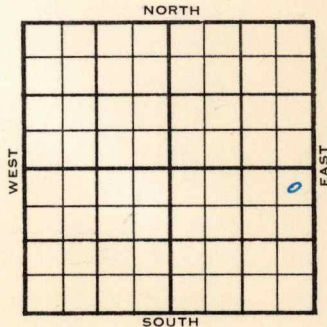

NE NE SE
Stanolind BHM & FO

1955	ELEVATION	REPORT
	2418'	

10/5	Comm 9-30-55		
	8" @ 188 w/125		
	Anh	1843	
	H-18	3065	3642
	Tr	3664	3660
	L	3677	3675
	BKC	3917	3910
	Marm		4012
	A		4118
	TD	4141	
	DST 3678-99 open 1 hr Rec50' wcm		
	1000#		
	D & A		

ABANDONED

County Trego Elev. _____
 Sec. 1 Twp. 12 Rge. 23W
 Company Transit Corp.
 Farm Name E. Rinker No. 1

TOPS	DEPTH	LOG	DATUM	Loc. in Sec.
Anh.	<u>1843</u>			<u>NE NE SE</u>
Tp.				
H.				
Tr.				
Dg.				
Bl.				
L.				Geol. _____
K.C.				Contr. _____
B.K.C.				<u>Co. tools</u>
Ce.				
C.				
M.				Pool _____
M.				<u>Wildcat</u>
K.				
Mz.				
Mq.				
V.				
S.				
S.				
A.				
R.				
PE.				
G.				
T.D.				

FIRST REPORT
 OCT 5 '56

Date Comm. 9-30-55 Stanolind BHM & FO
8" @ 188/125 drlg. 3065

[Red scribbles and faint stamp]

Co.
Lse.
No.
Sec.
T.
R.

County Trego Elev. 2418
 Sec. 1 Twp. 12 Rge. 23W
 Company Transit Corp.
 Farm Name E. Rinker No. 1

TOPS	DEPTH	LOG	DATUM
Anh.	1843		
TP.			
H.	3643	3642	1224
Tr.	3664	3660	1245
Dg.			
Bl.			
L.	3677	3675	1257
K.C.			
B.K.C.	3917	3910	1492
Ce. <u>norm</u>		4012	1594
C.			
M.			
M.			
K.			
Mz.			
Me.			
V.			
S.			
S.		4118	1700
A.			
R.			
PE.			
G.			
T.D.	4141		

Loc. in Sec. NE NE SE

Geol. _____

Contr. _____

Co. tools _____

Pool _____

Wildcat _____



Date Comm. 9-30-55 OCT 19 1955
8" @ 188/125 DST 3678-99 open 1 hr.

Rec. 50' wcm 1000#
D & A

Co.

Use.

No.

Sec.

T.

R.