


Trego

KANSAS

SECTION 1 TOWNSHIP 12S RANGE 23W

WELL NO. #1 Losee

COMPANY Imperial Oil Co.

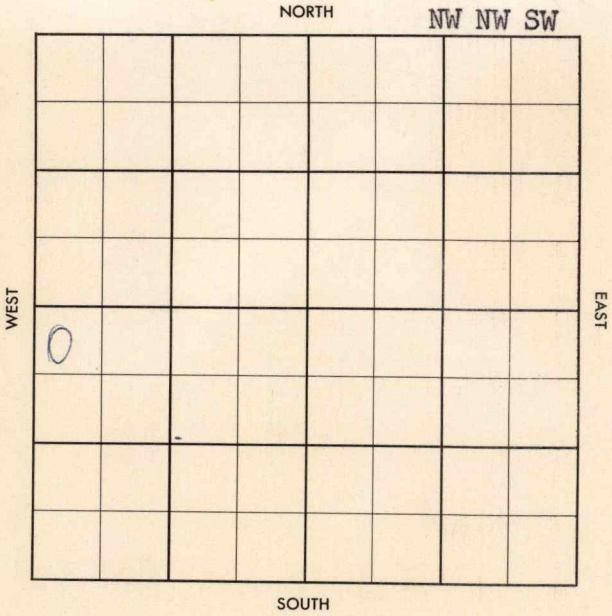

County Trego Elev. \_\_\_\_\_  
 Sec. 1 Twp. 12S Rge. 23W  
 Company Imperial Oil Co.  
 Farm Name Losee No. 1

TOPS	DEPTH	LOG	DATUM
Anh.			
Tp.			
H.			
Tr.			
Dg.			
Bl.			
L.			
K.C.			
B.K.C.			
Ce.			
C.			
M.			
M.			
K.			
Mz.			
Mo.			
V.			
S.			
S.			
A.			
R.			
Pe.			
G.			
T.D.			

Loc. in Sec. NW NW SW  
 Geol. \_\_\_\_\_  
 Contr. Harms-Burt  
 Pool \_\_\_\_\_  
Newcomer NW

FIRST REPORT  
 AUG 7 '57

Date Comm. \_\_\_\_\_  
 Loc. \_\_\_\_\_

5

County Trego Elev. 2426  
 Sec. 1 Twp. 12S Rge. 23W  
 Company Imperial Oil Co.  
 Farm Name Losee No. 1

Co.

TOPS	DEPTH	LOG	DATUM
Anh.	1851		
TP.			
H.	3636		
Tr.	3656		
Dg.			
Bl.			
L.	3670		
K.C.			
B.K.C.			
Ce.			
C.			
M.			
M.			
K.			
Mz.			
Ma.			
V.			
S.			
S.			
A.			
R.			
PE.			
G.			
TD.	3759		

Loc. in Sec. NW NW SW  
 Geol. \_\_\_\_\_  
 Contr. Harms-Burt  
 Pool \_\_\_\_\_  
 Newcomer NW

Use

COMPLETE  
 ○  
 SEP 25 '57

No.

Sec.

T.

R.

Date Comm.

Loc. 8-6-57 8578e  
220/175 DST 3643-65 op 1 hr  
3' md BHP 0 # DST 3698  
- 3718 op 2 hr Gas in the R 60' HOCM 6'  
oil 3' wtr BHP 540, DST 3734-56 op 2 hrs 500G  
180' HOCM 120' WM BHP 720 5 1/2 3756 ~  
MICT CO. DD TD 3759 test 9R WPH Sqw 2054 218  
3745-48 test 1G OPHN 14 1/2 14 BFPH 1 hrs, 100' OB.  
1/2 BOPH + wtr to Sqw CO 3759 MIG 23 '57 CO 3752

50 didn't hold \$ 1 GFph  
~~114~~ \$ 12 BFph (99% wt)  
 8 hrs Sed. Co. 31/3709-14  
~~112~~ \$ 8 Baph 8 hrs Pop.

SEP 4 '57    SEP 11 '57    SEP 18 '57    SEP 25 '57

207 B o p d + 6 91 w  
 39° Gr Lancing perfe