KANSAS


Rice

FORM 51 10M 8-47

Section 7 Township 18 Range 9W

Well No. #1 Bredfeldt

Company Palmer Oil

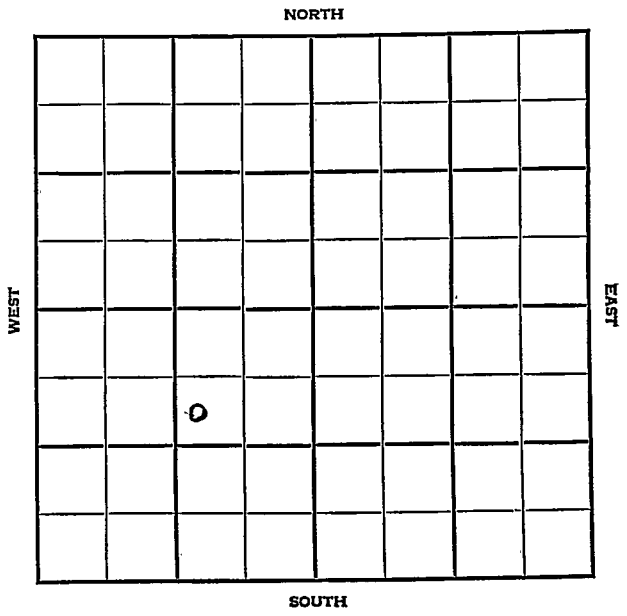

FORM 252-A
5M 4-48 PETROL

KANSAS

Rice

Sec. 7 Twp. 18 R. 9W

Well No. #1 Bredfeldt Farm

Palmer Oil Company

Volkland Pool


990' Ft. from N. Line

Ft. from S. Line

1080' Ft. from E. Line

Ft. from W. Line

SW NE SW

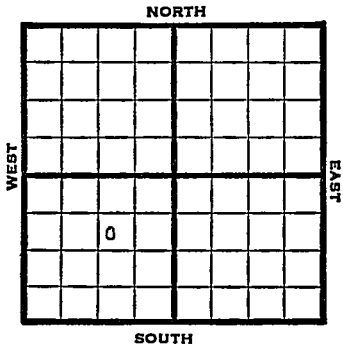

1948	E1 1742' REPORT
5/12	Location
5/19	8" @ 198' Drlg. 1210'
5/26	TD 2133' Lost Hole Skid 9' West 8" @ 181' Drlg. 1210'
6/1	Lansing 2881' Drlg. 2942'
6/9	Arbuckle 3226 5"@ 3228' TD 3235'
6/16	18 shots 3223-27 13 " 3229-33 - 1500 acid Pump 18 bbls oil PH
6/23	TD 3235' Arb. 3226' 5"@ 3228' 1500 acid Pump 448 oil pot 41[8] Gr. Comp COMPLETED

Form 26—200 Bks.—1-48—Palace

Volkland Pool

Kansas

Map No. _____ Sec. 7 Twp. 18 R. 9W

Well No. 1 Bredfeldt

Palmer Oil Company

FIRST REPORT Contractor

SW NE SW


990 Ft. from N. Line

_____ Ft. from S. Line

1080 Ft. from E. Line

_____ Ft. from W. Line

SECTION PLAT

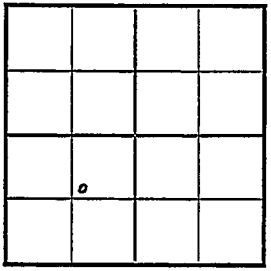

Rice County

Location X

Rig up

Drilling and Remarks:

RECORD

Cased _____ in., _____ ft.

Sand

Gas

Oil

Total Depth

PRODUCTION

1st 24 hrs. Nat.

1st 24 hrs. after shot

Gas _____ Cu. Ft.

Dry Hole

Abandoned

Date

MAY 1 2 1948 19

S. J. LEWIS Scout

Form 26—200 Bks.—1-48—Palace

Volkland Pool

Kansas

Map No. 45 Sec. 7 Twp. 18 R. 9W

Well No. 1 Bredfeldt

Palmer Oil Company

COMPLETE

Contractor

SW NE SW

E 1/2 1/2


SECTION PLAT

990 Ft. from N. Line

Ft. from S. Line

1080 Ft. from E. Line

Ft. from W. Line

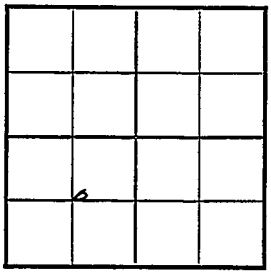

Rice County

Location

Rig up

Drilling and Remarks:

Cr # 3226

5" @ 3225.

1500 Acid

Pump 448 oil Bbls

41 EGL

RECORD

Cased in., ft.

Sand

Gas

Oil ✓

Total Depth 3225.

PRODUCTION

1st 24 hrs. Nat.

1st 24 hrs. after shot

Gas Cu. Ft.

Dry Hole

Abandoned

Date

JUN 23 1948 19

S. J. LEWIS Scout