


Section 36 Township 12 Range 22W

Well No. 1 Scott

Company Texas Company

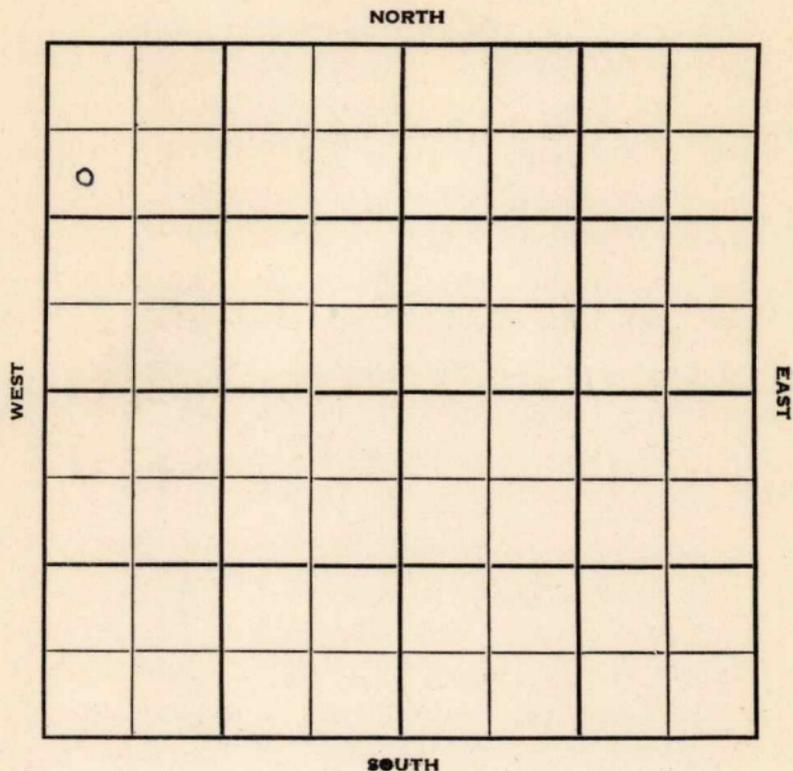

Trego

KANSAS

Sec. 36 Twp. 12 R. 22 W

Well No. # 1 Scott Farm

Texas Company Company

Contractor

Ogallah Pool


990 Ft. from N. Line

_____ Ft. from S. Line

_____ Ft. from E. Line

330 Ft. from W. Line

SW NW NW

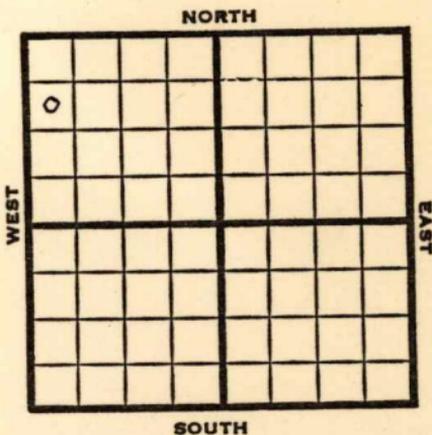

1951

Elev. 2330

REPORT

8/1

Location

10/17

Spud 8-18-51

Oil Well TD 4023

10" @ 499

KC 3598 Arb. 4013-23 TD

7" @ 4023 30/4014-23 500 A

S/85 bo 9 hr Comp. 321 bopd

COMPLETED

County **Trego** State **Kansas**

Sec. **36** (Blk. **12** (Sur. **22W** (Twp.) (Rge.) Map No.

Operator **Texas Company**

Well No. **1** Farm **Scott**

Elev. Location **SW NW NW**

0					

FIRST REPORT

990 Ft. From **N** Line **NW**

330 Ft. From **W** Line **Quarter**

Ist. Report **AUG 1 1951**

Completion

Remarks

Spudding Date

Drig. Data **Ogallah Pool**

Location

J. E. TYRA

County Trego State Kansas

Sec. 36 (Blk. 12 (Sur. Rge.) 22W Map No.

Operator Texas Company

Well No. 1 Farm Scott

Elev. 2330 Location SW NW NW

0					

COMPLETE

990 Ft. From N Line NW

330 Ft. From W Line Quarter

Ist. Report

Completion OCT 17 1951

Remarks Ogallah Pool

Spudding Date 8-18-51

Drlg. Data Oil well TD 4023

10" @ 499 KC 3598 Arb. 4013-23 TD

7" @ 4023 30/ 4014-23 500 A S/ 85 bo

9 hr. Comp. 321 bopd

J. E. TYRA