


Section 36 Township 12 Range 22W

Well No. #6 Scott

Company Texas

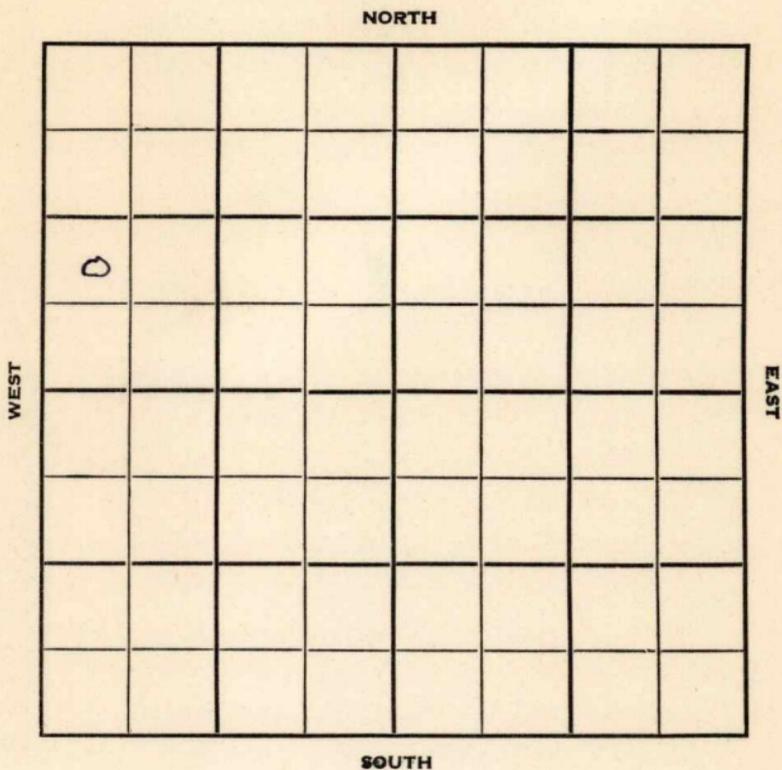

Trego

Sec. 36 Twp. 12 R. 22^W

Well No. #6 Scott Farm

Texas Company

Powell Contractor

Ogallah


_____ Ft. from N. Line

990 Ft. from S. Line

_____ Ft. from E. Line

330 Ft. from W. Line

NW SW NW

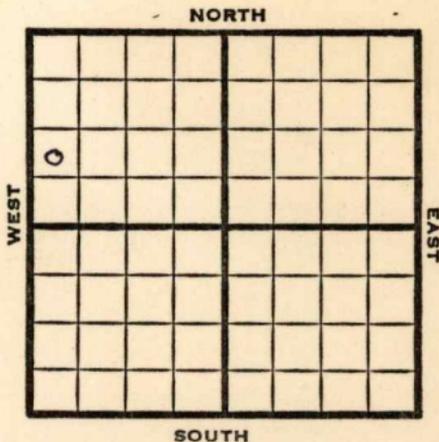

1952

Elev. 2327' REPORT

1/23

Spud 1-6-52
8" @ 503'
Drlg. 3080'

2/6

RTD 4010' 5" @ 4004'

2/13

TD 3976 DD 4000 TD
S/9 BOPH for 4 hrs.

2/20

Spud 1-6-52
Oil Well TD 4000
8" @ 503 **Heeb. 3971**
TD 3976 5" @ 3971 DD 4000
S/9 boph 4 hr. 500 A
Comp. 284 bopd

COMPLETED

