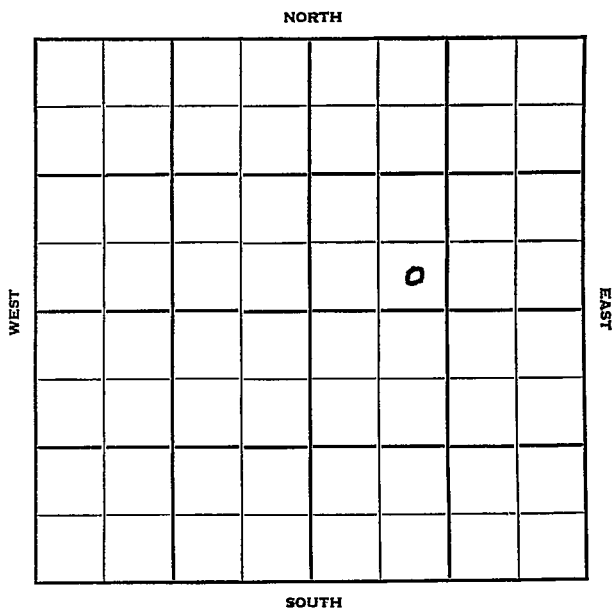


Section 7 Township 18 Range 9WWell No. #1 SchroederCompany Stagg Drlg. et al

Rice

KANSAS ✓

Sec. 7 Twp. 18 R. 9W

Well No. #1 Schroeder Farm

Stagg Drlg. et al Company

Stagg Contractor


 Ft. from N. Line

330 Ft. from S. Line

 Ft. from E. Line

990 Ft. from W. Line

SE SW NE

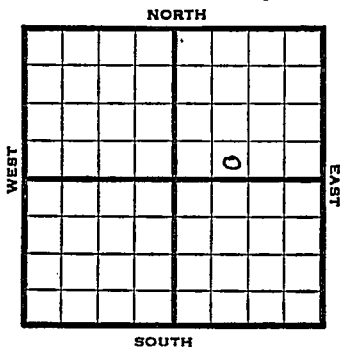

1952 Elev. 1743' REPORT

8/13 Spud 8-7-52
8" @ 155'
Drlg. 2417'

8/20 TD 3270'

8/27 NR

9/4 Spud 8-7-52
D&A TD 3270'
8" @ 155'
Top. 2488
Br Li 2882
B KC 3174
Arb. 3247
TD 3270' D&A

Heeb. 2762
Lans. 2897
Cong. 3227

ABANDONED

County Rice State Kansas
 Sec. 7 (Blk.) 18 (Sur.) SW Map No.
 Operator Stagg Drig. etal.
 Well No. 1 Farm Schroeder
 Elev. _____ Location SE SW NE

FIRST REPORT

330 Ft. From S Line NE
990 Ft. From N Line Quarter

1st. Report AUG 13 1952

Completion _____

Remarks _____

Stagg - Contr.


Spudding Date 8-7-52

Drlg. Data _____

8" • 155 Drlg. 2417

J. G. McGEHEE

County Rice State Kansas
 Sec. 7 (Blk. 18 (Sur. 9W Map No.
 (Twp.) (Rge.)
 Operator Stagg Drlg. etal.
 Well No. 1 Farm Schroeder
 Elev. 1743 Location SE SW NE

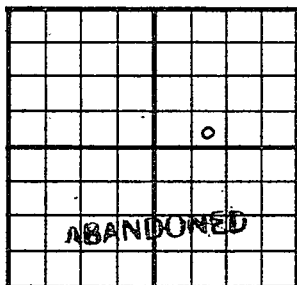

330Ft. From S Line NE
990Ft. From W Line Quarter

1st. Report

Completion SEP 4 1952

Remarks

Stagg Drlg. - Contr.

Spudding Date 8-7-52

Drlg. Data D & A TD 3270

8" @ 155 Top. 2488 Heeb. 2762

Br. lime 2882 Lens. 2897 B KC 3174

Cong. 3227 Arb. 3247 TD 3270

D & A

J. G. McGEHEE