


KANSAS

Map No. _____ Sec. 21 Twp. 33 R. 2EWell No. 1-Melick Farm _____Helmerrick & Payne Company

NORTH

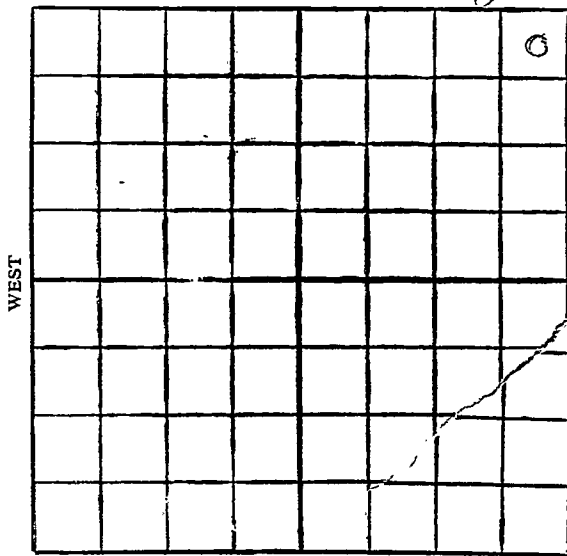

SOUTH

Location _____

Drilling Remarks _____

Rig Up _____

Drilling Remarks _____

RECORD

Cased _____ in. _____ ft.

Sand _____

Gas _____

Oil _____

Total Depth _____

PRODUCTION

1st 24 hrs. Nat. _____

1st 24 hrs. after shot _____

Gas _____ cu. ft.

Dry Hole _____

Abandoned _____


KANSAS

Map No. _____ Sec. 21 Twp. 33 R. 2EWell No. 1-Melick Farm _____Helmerick & Payne Company330 Ft. from N. Line

_____ Ft. from S. Line

330 Ft. from E. Line

_____ Ft. from W. Line

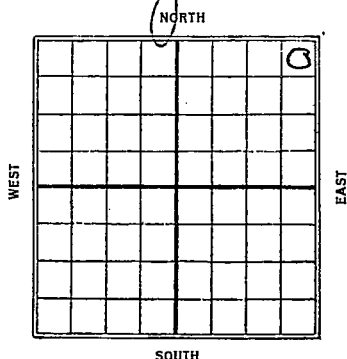

1928

Date

REPORT

3/7	Rig Building
3/14	Rigging up-
3/21	Rigged up-
3/28	
4/4	Spud
4/11	Drlg 715
4/18	" 1100
4/25	" 1465
5/2	" 1675
5/9	T.D. 1900 - 2. R. 10"
5/16	Spud 2290 - 2330 - H.F.W. drilling 2330-
5/23	Drlg 2840
5/31	" 3030
6/6	Chat 3285 - 3310 - Show oil straight run 6"
6/13	T.D. 3425 - re. bldg rig-
6/20	Rigging up-
6/27	no report-
7/3	Drlg 3460
7/11	T.D. 3587 L.R.D.

Map No. 1 **KANSAS** Sec. 21 Twp. 33 R. 2EWell No. 1 MelickHeimerich & Payne Company

Contractor

SECTION PLAT

330 Ft. from N. Line

----- Ft. from S. Line

330 Ft. from E. Line

----- Ft. from W. Line

			0

FIRST REPORTS

Location -----

Rig up -----

Drilling and Remarks:

Rig Buildg

RECORD

Cased ----- in., ----- ft.

Sand -----

Gas -----

Oil -----

Total Depth -----

PRODUCTION

1st 24 hrs. Nat. -----

1st 24 hrs. after shot -----

Gas ----- Cu. Ft.

Dry Hole -----

Abandoned -----

Date

MAR 7 1928

S. J. LEWIS Scout

K1
 Map No. KANSAS Sec. 21 Twp. 33 R. 2E

Well No. 1 Mc Lick

Heimerich & Payne Company

Contractor

SECTION PLAT

330 Ft. from N. Line

_____ Ft. from S. Line

330 Ft. from E. Line

_____ Ft. from W. Line

			0

ABANDONED

Location _____

Rig up _____

Drilling and Remarks:

Total Depth.

3587

D & A

RECORD

Cased _____ in., _____ ft.

Sand _____

Gas _____

Oil _____

Total Depth _____

PRODUCTION

1st 24 hrs. Nat. _____

1st 24 hrs. after shot _____

Gas _____ Cu. Ft.

Dry Hole _____

Abandoned _____

Date _____

JUL 11 1928 S. J. LEWIS Scout

Summer
 K 1 **KANSAS** SEC. *21* TWP. *33S* R. *2E*
 MAP NO.

WELL NO. *1 Melick*
Helmreich-Payne COMPANY

CONTRACTOR

SECTION PLAT

			0

_____ FT. FROM N. LINE

_____ FT. FROM S. LINE

_____ FT. FROM E. LINE

_____ FT. FROM W. LINE

LOCATION _____

RIG UP _____

DRILLING AND REMARKS:

3540-69
H. 2 1/4
we show
3587

RECORD

CASED _____ IN. _____ FT.

SAND _____

GAS _____

OIL _____

TOTAL DEPTH *3551*

PRODUCTION

1ST 24 HRS. NAT. _____

1ST 24 HRS. AFTER SHOT _____

GAS _____ CU. FT.

DRY HOLE ☒ABANDONED ☒

DATE

7/11

192 *8*

SCOUT