

Sumner


DX 78-1

KANSAS

Section 21 Township 33 Range 2E

Well No. #3 Rutter

Company Aladdin

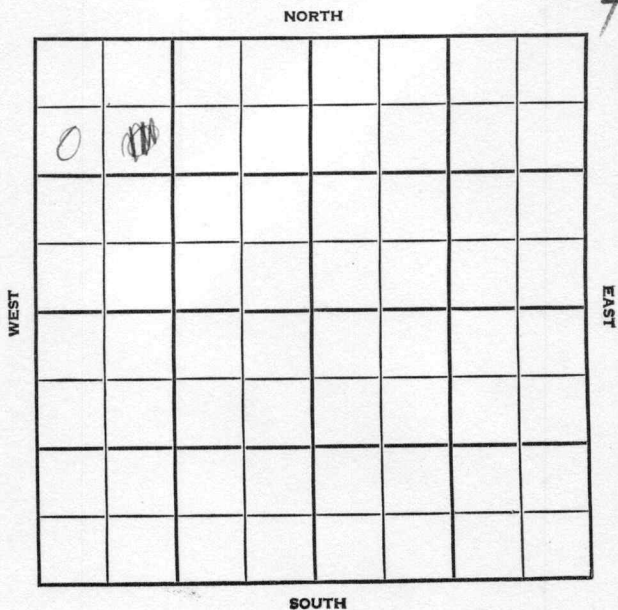

County Sumner Elev. _____
 Sec. 21 Twp. 33 Rge. 2E
 Company Aladdin
 Farm Name Rutter No. 3

TOPS	DEPTH	LOG	DATUM	Loc. in Sec.
Anh.				SW NW NW
Tr.				
H.				
Tr.				
Dg.				
Bl.				
L.				Geol. _____
K.C.				Contr. _____
B.K.C.				
Ce.				Crowe Drlg.
C.				
M.				Pool
M.				Rutter
K.				
Mz.				
Mq.				
V.				
S.				
S.				
A.				
R.				
Pe.				
G.				
T.D.				

Date Comm. 11-29-56
8" @ 92 drlg. 1280

DEC 5 '56
 FIRST REPORT

297

County SumnerElev. 1134Sec. 21Twp. 33Rge. 2ECompany AladdinFarm Name RutterNo. 3

TOPS	DEPTH	LOG	DATUM	Loc. in Sec.
Anh.				SW NW NW
Tp.				
H.				
Tr.				
Dg. <u>424</u>	<u>2651</u>	<u>2648</u>		
Bl.				
L.				
K.C.	<u>2800</u>	<u>2790</u>		Geol.
B.K.C.				Contr.
Ce. <u>Marm</u>	<u>2979</u>	<u>2979</u>		Crowe Drlg.
C.				
M.	<u>3199</u>	<u>3199</u>		Pool
M.				Rutter
K.		<u>3330</u>		
Mz.				
Mq.				
V.				
S. <u>3d</u>		<u>3374</u>		
S.				
A.		<u>3416</u>		
R.				
Pe.				
G.				
TD.	<u>3455</u>			

0

JAN 2 '57

COMPLETE

Date Comm. 11-29-568" @ 92 drlg. 1280 DEC 12 '56 3279DEC 19 '56 DST 3376-97 1m 62'50' 6CM BHP 90/20" DST3409-14 20" 30' 50CM BHP80/20" DST 3410-26 27"6 1/4" Fluid oil 27" no resBHP 1220/20" 5 1/2 3454 DEC 26 '56co 36/3413-23 & 4 1/2 Bophno/w POP JAN 2 '57 est P. 50 Bopdno/w to