

KANSAS

FORM 51 5M 4-41 PETROL

Sumner

Section 21 Township 33 Range 2-E


Well No. #2 Rutter

Company E. B. Shawver

NORTH

Rutter Pool 5

WEST

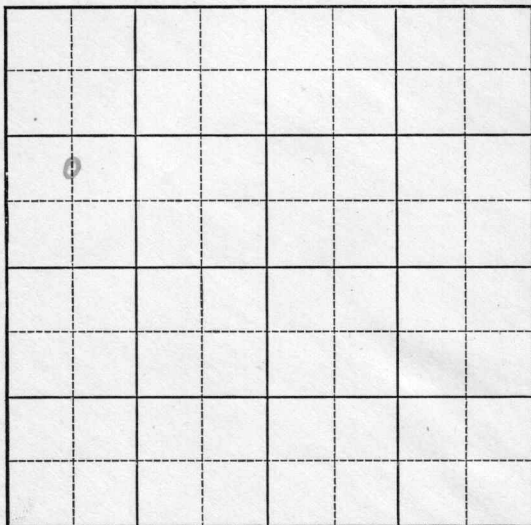

EAST

SOUTH

KANSAS


Sumner

Sec. 21 Twp. 33 R. 2-EWell No. #2 Rutter FarmE. B. Shawver Company

(Rutter)

 Ft. from N. Line990 Ft. from S. Line Ft. from E. Line660 Ft. from W. Line

Elev. 1141

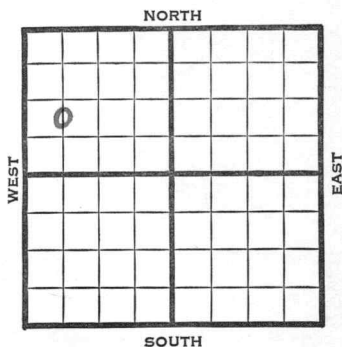

1941

REPORT

4/9 Drlg. 2200'

4/18 ~~Miss.~~ 3226' & 7". RUST.

4/24 Miss. 3244' (Corrected)

7" - 3226' T.D. 3266' Testg.

4/30 Miss. 3244'

7" - 3226'

T.D. 3266'

Pump 15 bbls.

39. Gravity

COMPLETED

Map No. 1 Sec. 21 Twp. 33 R. 2EWell No. 2 RutterE. B. Shawver

Company

Contractor

FIRST REPORT

C N L SW NW

 Ft. from N. Line990 Ft. from S. Line Ft. from E. Line660 Ft. from W. Line

SECTION PLAT

D			

RUTTER POOL

Location Rig up

Drilling and Remarks:

Drlg. 2200

RECORD

Cased in., ft.Sand Gas Oil Total Depth

PRODUCTION

1st 24 hrs. Nat. 1st 24 hrs. after shot Gas Cu. Ft.Dry Hole Abandoned

Date

APR 9 1941 19

S. J. LEWIS

Scout

Map No. 1 Sec. 21 Twp. 33 R. 2EWell No. 2 RutterE. B. Shawver

Company

COMPLETED

Contractor

C N L SW NW

 Ft. from N. Line990 Ft. from S. Line Ft. from E. Line660 Ft. from W. Line

RUTTER POOL

SECTION PLAT

o			

Location Rig up

Drilling and Remarks:

*Miss 8244**7" @ 3226**Pump 15 ft.**39° Gr*

RECORD

Cased in., ft.Sand Gas Oil Total Depth 3266

PRODUCTION

1st 24 hrs. Nat. 1st 24 hrs. after shot Gas Cu. Ft.Dry Hole Abandoned

Date

APR 30 1941 19

S. J. LEWIS Scout