


DX 78-1 Sumner

KANSAS

Section 21 Township 33 Range 3E 2E

Well No. #2 Rutter

Company Aladdin Pet.

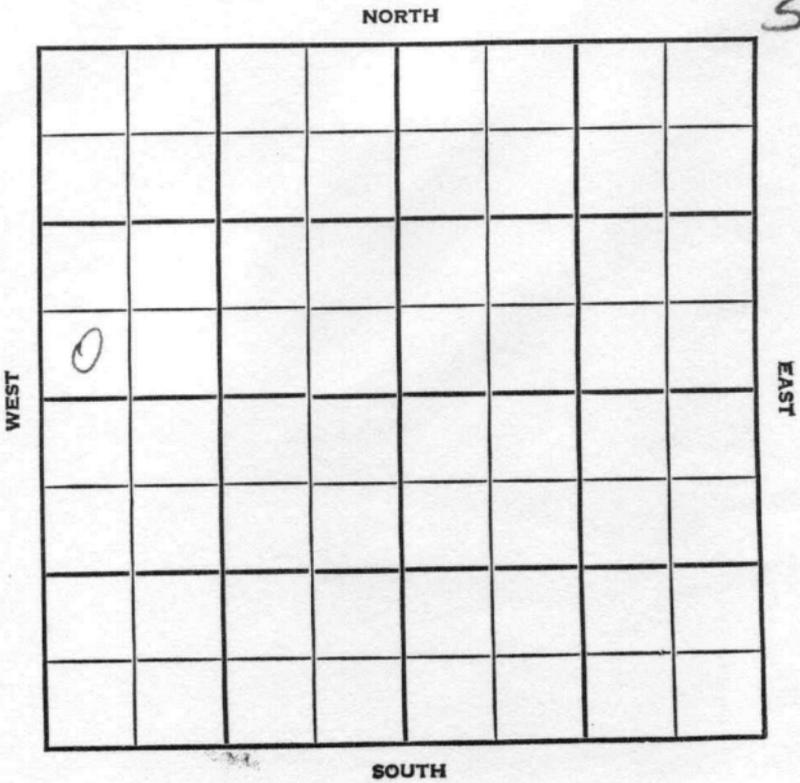

Sumner

KANSAS

SEC. 21

TWP. 33

R. ~~BE~~ 2E

WELL NO. #2 Rutter FARM

COMPANY Aladdin Petr.

CONTRACTOR Crowe

Rutter


_____ FT. FROM N. LINE

_____ FT. FROM S. LINE

_____ FT. FROM E. LINE

_____ FT. FROM W. LINE

SW SW NW

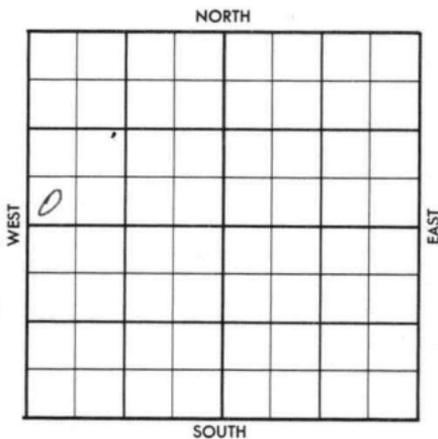

1956

ELEVATION

1157 KB

REPORT

7-18 Comm. 7-13-56
8" @ 125 w/100
Drlg. 841

7-25 D & A
KC. 2839'; Osw. 3028'; M. 3263';
TD 3306'

ABANDONED

