


Section 24 Township 33 Range 2E

Well No. 1 Holman

Company H & S etal.

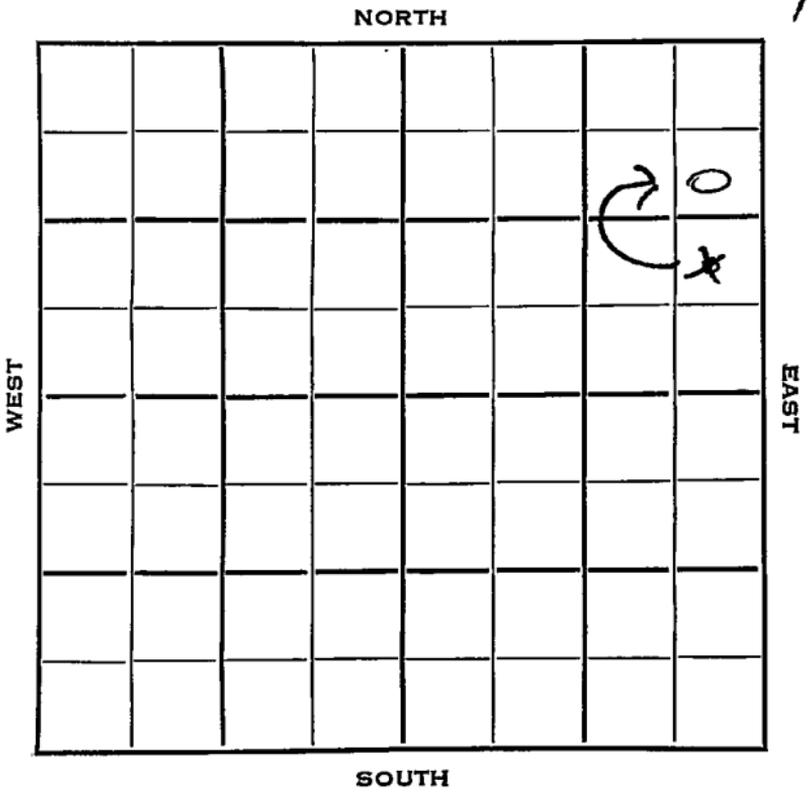

Sec. 24 Twp. 33 R. 2E

Well No. #1 Holman Farm

H & S et al Company

Empire Drlg. Contractor

W. Rainbow Bend Pool

950 Ft. from N. Line


990 Ft. from S. Line

250
330 Ft. from E. Line

_____ Ft. from W. Line

~~SE NE NE~~

~~NE SE NE~~

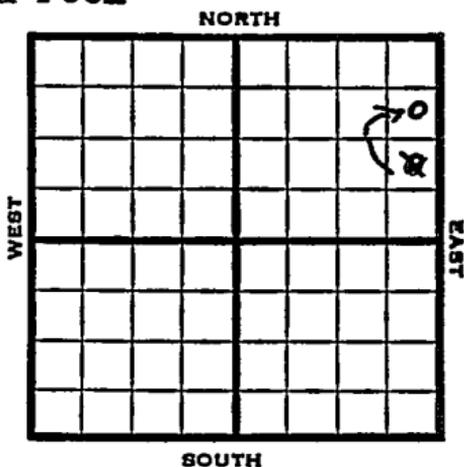

1953 Elev. 1106' REPORT

4/8 Spud 4-2-53
8" @ 101
Drlg. 2340'

4/29 Spud 4-2-53 D & A TD 3277
8" @ 101 Bart 3254
DST 3251-67 open 1 hr rec 16' mud
TD 3267 5" @ 3255 Layton 2630
KC 2796 Oswego 2996 DD 3277 Hydro
HFW PB 3256 wtr.
D & A

ABANDONED

Map No. _____ Sec. 24 Twp. 33 R. 2E

Well No. 1 Holman

H & S etal. Company

CORRECTION Contractor

SE NE NE

SECTION PLAT

950 Ft. from N. Line

_____ Ft. from S. Line

250 Ft. from E. Line

_____ Ft. from W. Line

				o

Sumner County

Location _____

Rig up _____

Drilling and Remarks:

Reported

NE SE NE

RECORD

Cased _____ in., _____ ft.

Sand _____

Gas _____

Oil _____

Total Depth _____

PRODUCTION

1st 24 hrs. Nat. _____

1st 24 hrs. after shot _____

Gas _____ Cu. Ft.

Dry Hole _____

Abandoned _____

Date

APR 8 1953

19

J. G. McGEHEE

Scout

