

Rice

KANSAS


SECTION 8 TOWNSHIP 18 RANGE 9W

WELL NO. #1 Gouldner

COMPANY Sterling Drlg.

NORTH

SW SW NW

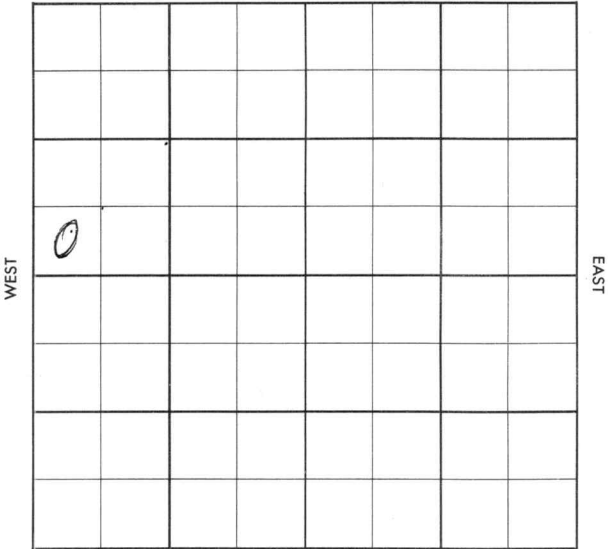

SOUTH

County Rice Elev. _____
 Sec. 8 Twp. 18 Rge. 9W
 Company Sterling Drlg.
 Farm Name Gouldner No. 1

TOPS	DEPTH	LOG	DATUM	Loc. in Sec.
Anh.				SW SW NW
Tr.				
H.				
Tr.				
Dg.				
B.L.				
L.				Geol. _____
K.C.				Contr. _____
B.K.C.				
Ce.				Co. Tools
C.				
M.				Pool
M.				Gouldner (Abd)
K.				
Mz.				
Mq.				
V.				
S.				FIRST REPORT
S.				
A.				
R.				
Pf.				
G.				
T.D.				

MAY 29 57

Date Comm. _____
 Location _____

Handwritten mark: a large 'X' or '1/2' scribble.

Co.
Lse.
No.
Sec.
T.
R.

County Rice Elev. 1750
 Sec. 8 Twp. 18 Rge. 9W
 Company Sterling Drlg.
 Farm Name Gouldner No. 1

TOPS	DEPTH	LOG	DATUM	Loc. in Sec.									
Anb.				SW SW NW									
Tr.	2764												
Dg.													
Bl.	2886			Geol.									
L.	2906												
K.C.				Contr.									
Ce.													
C.	3227			Co. Tools									
M.				Pool									
M.													
K.				Gouldner (Abd)									
Mz.													
Me.				<table border="1"> <tr> <td></td> <td>AUG 7 '57</td> <td></td> </tr> <tr> <td></td> <td></td> <td></td> </tr> <tr> <td></td> <td></td> <td></td> </tr> </table>		AUG 7 '57							
	AUG 7 '57												
V.													
S.													
S.	3244												
A.													
R.													
Pe.													
G.													
TD	3250												

Date Comm. Location JUN 5 '57 JUN 12 '57 MIRT JUN 19 '57

6-12-57 858 225 #2720
 DST 2991-3005 1hr 20"
 56' OCM + 60' MCW BHP 820
 DST 3244-50 90" rec 30 56'
 HOCM + 20' Freeoil 850/20" 5 1/2
 3244/150 JUL 2 '57 CO 3250 TD
 B 15 60ph 3hrs 1/2 \$ 294
 GOT 46 GW 1 \$ 10 BF (1/3 wtr)
 in 90"

\$ 15 B0 + 17 BW in 4 1/2
 hrs FU 660' oil + 1435'
 wtr 14 hrs JUL 10 '57 JUL 17 '57 \$ 13
 B0 + 19 BW 5 hrs Pot JUL 24 '57
 JUL 31 '57 AUG 6 '57 P. 20 B0 + 84
 Bwpd P. 15 B0 + 100
 Bwpd
 Temp Add.