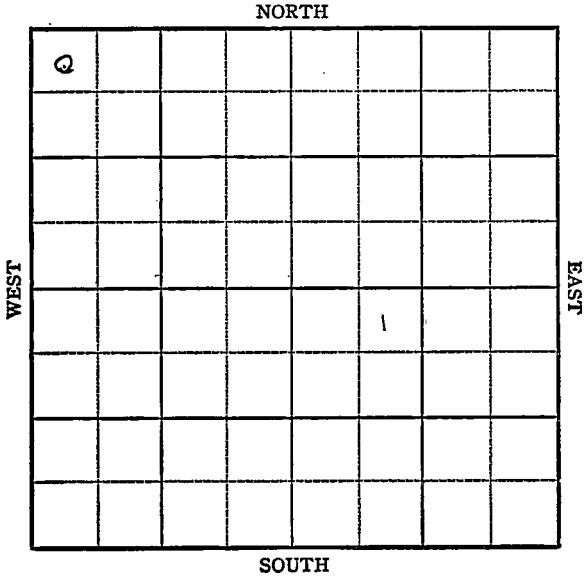


Section 8 Township 18 Range 9-WWell No. #1 Guldner 'A' (K65 PRL)Company Birmingham & Bartlett
Wildcat

KANSAS

Rice

Sec. 58 Twp. 18 R. 9W ☒

Well No. #1 Guldner 'A' (KGS DRL) Farm

Birmingham & Bartlett Company

Wildcat


330' Ft. from N. Line

 Ft. from S. Line

 Ft. from E. Line

330' Ft. from W. Line

NW/C

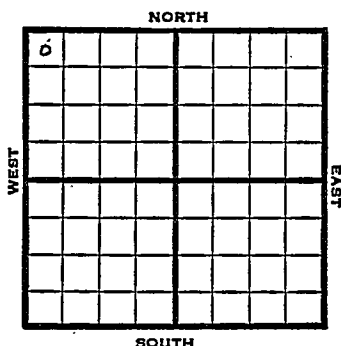

1948

Elev. 1751' REPORT

12/1	8" @ 205'
	Drlg. 1290'
12/8	Lansing 2898'
	Arb. 3235'
	TD 3243'
	5" @ 3236'
12/15	TD 3244
	1500 ac ^{9d}
	Swb 59 bbls oil / 54 W 15 hrs.
12/22	"
12/29	"
1/5	"
1/12	"
1/19	"
1/26	Arb. 3235'
	5" @ 3236'
	TD 3244'
	ABANDONED

Kansas

Map No. _____ Sec. 8 Twp. 18 R. 9W

Well No. 1 Guldner 'A' (KGS DRL)


Birmingham & Bartlett Company

FIRST REPORT

Contractor

NW/C

SECTION PLAT

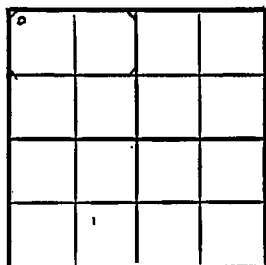

330 Ft. from N. Line

Ft. from S. Line

Ft. from E. Line

330 Ft. from W. Line

Rice County

Location _____

Rig up _____

Drilling and Remarks:

8" @ 205

drlg. 1290

RECORD

Cased _____ in. _____ ft.

Sand _____

Gas _____

Oil _____

Total Depth _____

PRODUCTION

1st 24 hrs. Nat. _____

1st 24 hrs. after shot _____

Gas _____ Cu. Ft.

Dry Hole _____

Abandoned _____


Date

DEC 1 1948 19 S. J. LEWIS Scout

Kansas

Map No. 45 Sec. 8 Twp. 18 R. 9WWell No. 1 Guldner 'A' (KGS DRL)Birmingham & Bartlett CompanyABANDONED Contractor

NW/C

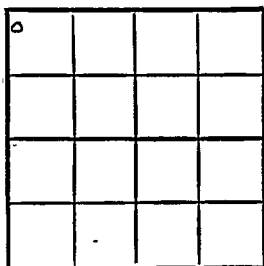E 11751
SECTION PLAT330 Ft. from N. Line Ft. from S. Line Ft. from E. Line330 Ft. from W. Line

Rice County

Location Rig up

Drilling and Remarks:

Q 832355" @ 3236

RECORD

Cased in., ft.Sand Gas Oil Total Depth 3244

PRODUCTION

1st 24 hrs. Nat. 1st 24 hrs. after shot Gas Cu. Ft.Dry Hole Abandoned

Date

JAN 26 1949 19S. J. LEWIS Scout