


Map No. KANSAS Sec. 9 Twp. 18 R. 9W

Well No. 3- Haldner Farm \_\_\_\_\_  
Empire Company \_\_\_\_\_

NORTH

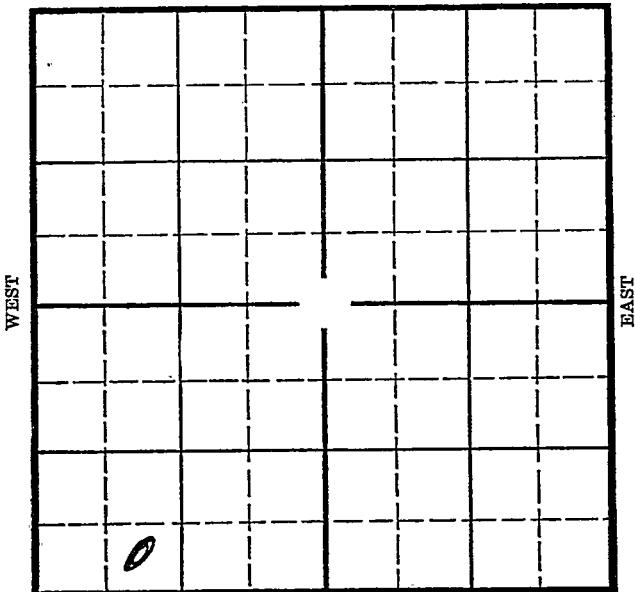

SOUTH

Location \_\_\_\_\_

Drilling Remarks \_\_\_\_\_

\_\_\_\_\_

\_\_\_\_\_

Rig Up \_\_\_\_\_

Drilling Remarks \_\_\_\_\_

\_\_\_\_\_

\_\_\_\_\_

RECORD

Cased \_\_\_\_\_ in. \_\_\_\_\_ ft.

Sand \_\_\_\_\_

Gas \_\_\_\_\_

Oil \_\_\_\_\_

Total Depth \_\_\_\_\_

PRODUCTION

1st 24 hrs. Nat. \_\_\_\_\_

1st 24 hrs. after shot \_\_\_\_\_

Gas \_\_\_\_\_ cu. ft.

Dry Hole \_\_\_\_\_

Abandoned \_\_\_\_\_

Rice

Map No. KANSAS Sec. 9 Twp. 18 R. 9W

Well No. 3- Muldner Farm  
Empire Company


\_\_\_\_\_ Ft. from N. Line

330 Ft. from S. Line

\_\_\_\_\_ Ft. from E. Line

990 Ft. from W. Line

Elev. 1743

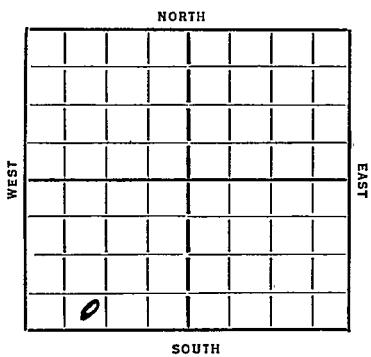

REPORT

DATE  
1/15  
1/24  
1/31  
2/7  
2/14  
2/21  
2/28  
3/6  
3/13  
3/25

Location  
\_\_\_\_\_  
12" 225 WOC  
Dlg 2300  
" 2750  
log pipe  
CO  
7" 3213 TD 3219 WOC  
Dlg 3227  
TD 3239.  
964 Oil 2% water

COMPLETED

KANSAS

Map No. 45 Sec. 9 Twp. 18 R. 9<sup>th</sup>

Well No. 3 - Guldner

Empire Company

Contractor

FIRST REPORTS

..... Ft. from N. Line

330 Ft. from S. Line

..... Ft. from E. Line

990 Ft. from W. Line

SECTION PLAT

0			

Location

Rig up.....

Drilling and Remarks:

RECORD

Cased..... in., ..... ft.

Sand.....

Gas.....

Oil.....

Total Depth.....

PRODUCTION

1st 24 hrs. Nat.....

1st 24 hrs. after shot.....

Gas..... Cu. Ft.

Dry Hole.....

Abandoned.....

Date

ORVAL MANNSCHRECK

1-15-36 192.....

Scout

Map No. 45 Sec. 9 Twp. 18 R. 9W

Well No. 3 Gulcher

Empire O & G. Company

Contractor

**SECTION PLAT**

0			

..... Ft. from N. Line

330 Ft. from S. Line

..... Ft. from E. Line

990 Ft. from W. Line

**COMPLETE**

Location.....

Rig up.....

Drilling and Remarks:

*Sil 3227 -  
964 oil  
2 7/8 Water*

**RECORD**

Cased..... in., ..... ft.

Sand.....

Gas.....

Oil.....

Total Depth..... 3239

**PRODUCTION**

1st 24 hrs. Nat.....

1st 24 hrs. after shot.....

Gas..... Cu. Ft.

Dry Hole.....

Abandoned.....

Date

3/25/36 192.....

S. J. LEWIS Scout