

Rice

KANSAS


9W

SECTION 10 TOWNSHIP 18 RANGE

WELL NO. #1 Groth

COMPANY Isern Drlg

NORTH

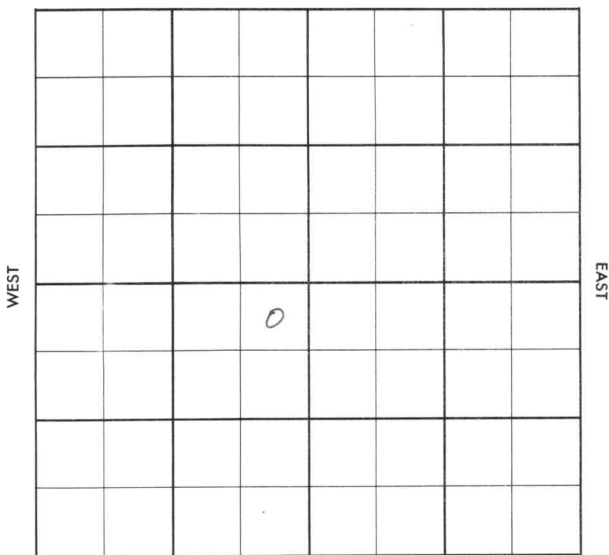

SOUTH

Rice

KANSAS

SEC. 10	TWP. 18	R. 9W
------------	------------	----------

WELL NO.

#1 Groth

FARM

COMPANY

Isern Drlg.

CONTRACTOR

Frederick


Ft. from N. Line

Ft. from S. Line

Ft. from E. Line

Ft. from W. Line

NE NE SW

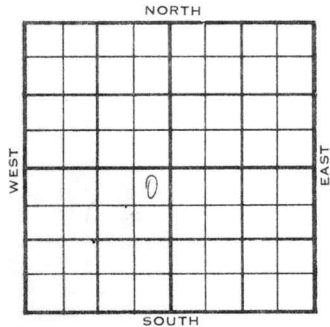

1956

ELEVATION
1736

REPORT

4-25
6-27

Cellar & pits
 Comm. 5-3-56
 8 5/8" @ 224/
 5 1/2" @ 3230
 co
 DD 3237 TD Frac.
 § 2 1/2 BOPH no/W POP
 P 3380 / 35 BW/24 hrs
 PH R. 31 BOPD no water, grav. 47°
 H. 2734; BL. 2850; L. 2871; S. Sh.
 3222; S. 3225
 TD. 3235

COMPLETED

County Rice Elev. _____
 Sec. 10 Twp. 18 Rge. 9W
 Company Isern Drlg.
 Farm Name Groth No. 1

TOPS	DEPTH	LOG	DATUM
Anh.			
Tp.			
H.			
Tr.			
Dg.			
BL.			
L.			
K.C.			
B.K.C.			
Ce.			
C.			
M.			
M.			
K.			
Mz.			
Mq.			
V.			
S.			
S.			
A.			
R.			
Pe.			
G.			
T.D.			

Loc. in Sec. _____

NE NE SW

Geol. _____

Contr. _____

Pool _____

Frederick

FIRST REPORT	
0	
APR 25 '36	


Date Comm. _____

Cellar & pits

8201 S YAM

R. G. S.

County Rice Elev. 1736
 Sec. 10 Twp. 18 Rgs. 9W
 Company Isern Drlg.
 Farm Name Groth No. 1

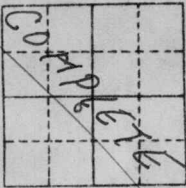TOPS	DEPTH	LOG	DATUM	Loc. in Sec.
Anh.				NE NE SW
TP.				
H.	2734			
Tr.				
Dg.				
BL.	2850			
L.	2871			Geol.
K.C.				Contr.
B.K.C.				
Ce.				
C.				
M.				Pool
M.				Frederick
K.				
Mz.				
Mo.				
V.				
S. 34	3222			
S.	3225			
A.				
R.				
Pe.				
G.				
TD.	3235			

Date Comm.

JUN 27 '56

Cellar & pits MAY 2 '56 MAY 9 '56 5-3-56

878 224/ 5 1/2 @ 3230 MAY 16 '56

CO MAY 23 '56 DD 3237 TD Frac

2 1/2 Boph no/w Pot MAY 29 '56

JUN 6 '56 JUN 13 '56 3380 + 35 BW/24hr

JUN 20 '56 JUN 27 '56 Ph R. 31 Boph

no wtr gran 47°