

DX 78-1


Rice

KANSAS

Section 9 Township 18 Range 9 W

Well No. #1 Lewis

Company Lewis Drlg.

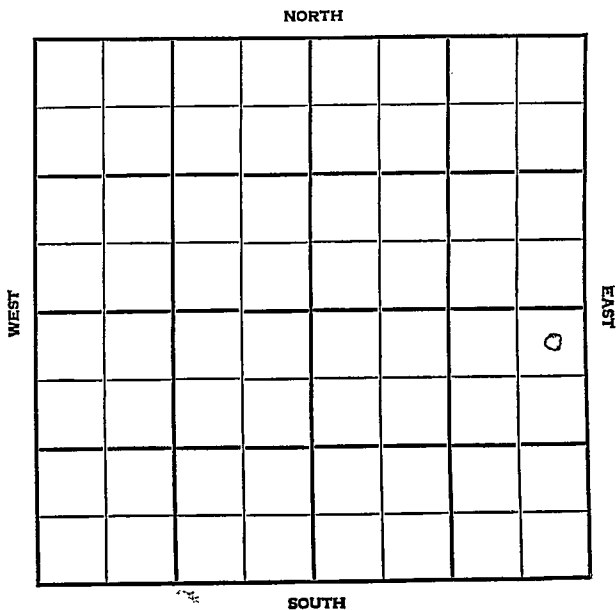

Rice

KANSAS

SEC. 9	TWP. 18	R. 9W
-----------	------------	----------

WELL NO. #1 Lewis FARM  
COMPANY

Lewis Drlg.  
CONTRACTOR


Co. Tools  
Semi-Wildcat

\_\_\_\_\_ Ft. from N. Line

\_\_\_\_\_ Ft. from S. Line

\_\_\_\_\_ Ft. from E. Line

\_\_\_\_\_ Ft. from W. Line

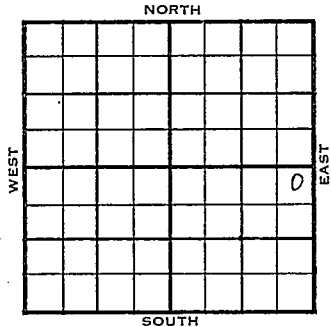

NE NE SE

1956	ELEVATION 1732	REPORT
------	-------------------	--------

3-14 Comm. 3-9-56  
8" @ 200/175  
Drlg. 1253

4-4 D & A  
H. 2750  
BL. 2874  
L. 2898  
BKC 3177  
S. 3251  
A. 3272  
TD 3300

**ABANDONED**



