


Map No. **KANSAS** Sec. 9 Twp. 18 R. 9W  
Well No. 2 - Golden Farm  
Empire Oil Company

*Rice*

NORTH

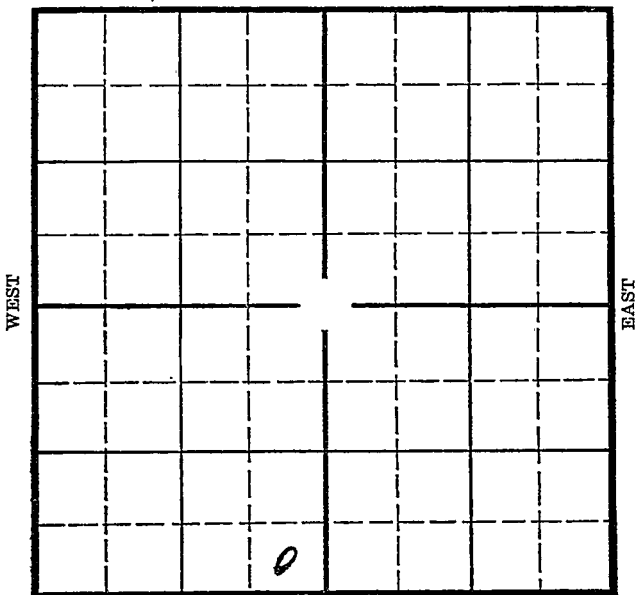

SOUTH

Location \_\_\_\_\_

Drilling Remarks \_\_\_\_\_

Rig Up \_\_\_\_\_

Drilling Remarks \_\_\_\_\_

**RECORD**

Cased \_\_\_\_\_ in. \_\_\_\_\_ ft.

Sand \_\_\_\_\_

Gas \_\_\_\_\_

Oil \_\_\_\_\_

Total Depth \_\_\_\_\_

**PRODUCTION**

1st 24 hrs. Nat. \_\_\_\_\_

1st 24 hrs. after shot \_\_\_\_\_

Gas \_\_\_\_\_ cu. ft. \_\_\_\_\_

Dry Hole \_\_\_\_\_

Abandoned \_\_\_\_\_

*Rice*  
*9W*

Map No. KANSAS Sec. 9 Twp. 18 R. 9W

Well No. 2- Guldner Farm \_\_\_\_\_  
Empire Oil Company \_\_\_\_\_


\_\_\_\_\_ Ft. from N. Line

330 Ft. from S. Line

330 Ft. from E. Line

\_\_\_\_\_ Ft. from W. Line

Elevation 1744 1741

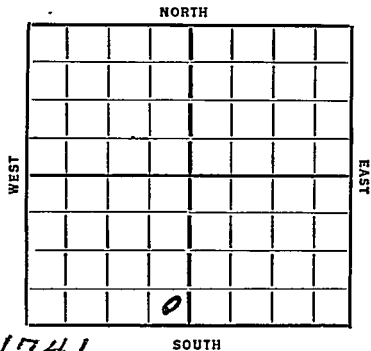

REPORT

Date	Description
1935	
11/27	Location
12/6	B.C.
12/13	13" 205 WOC
12/19	Wlg 1750
12/26	" 3043
1/2/36	7" 3214 Bailing
1/8	Oil 3253
	TD 3260
	800' Water 27 hrs
	D & A.
	ABANDONED

Map No. 45 Sec. 9 Twp. 18 R. 9W

Well No. 2 - Galesnes

Empire oil Company

Contractor

*ORVAL MANSCHRECK*

SECTION PLAT


Ft. from N. Line

330 Ft. from S. Line

330 Ft. from E. Line

Ft. from W. Line

Location

Rig up

Drilling and Remarks:

RECORD

Cased.....in., .....ft.

Sand.....

Gas.....

Oil.....

Total Depth.....

PRODUCTION

1st 24 hrs. Nat.....

1st 24 hrs. after shot.....

Gas.....Cu. Ft.

Dry Hole.....

Abandoned.....

Date

11-27-35 192.....

**ORVAL MANSCHRECK**  
Scout

Map No. 45 Sec. 9 Twp. 18 R. 9W

Well No. 2-Gulbner

Empire Company

Contractor

SECTION PLAT


.....Ft. from N. Line

330 Ft. from S. Line

330 Ft. from E. Line

.....Ft. from W. Line

**COMPLETED**

Location.....

Rig up.....

Drilling and Remarks:

800' water - 22 hrs

D. T. A.

RECORD

Cased.....in., .....ft.

Sand Sil. 3253

Gas.....

Oil.....

Total Depth 3260

PRODUCTION

1st 24 hrs. Nat.....

1st 24 hrs. after shot.....

Gas.....Cu. Ft.

Dry Hole.....

Abandoned.....

Date

JAN 8 1936