SIDE ONE

36-9-21E

STATE CORPORATION COMMISSION OF KANSAS
OIL & GAS CONSERVATION DIVISION
WELL COMPLETION OR RECOMPLETION FORM
ACO-1 WELL HISTORY
DESCRIPTION OF WELL AND LEASE

API NO. 15-103-21,079

County Leavenworth

NE NE NW Sec. 36 Twp. 9 Rge. 21 X East __ West

4950 Ft North from Southeast Corner of Section
2970 Ft West from Southeast Corner of Section
(Note: Locate well in section plat below)

Lease Name Barnhardt Well # 1

Field Name Wildcat

Producing Formation McLouth

Elevation: Ground ____ KB 976

Operator: License # 3100
Name D & I, Inc.
Address P.O. Box 42
City/State/Zip Leavenworth, Ks 66048

Purchaser n/a

Operator Contact Person Dale A. Smith
Phone 913-651-8188

Contractor: License # 4160
Name Hutton Drilling Co.

Wellsite Geologist Dave Griffin
Phone 913-842-3665

Section Plat

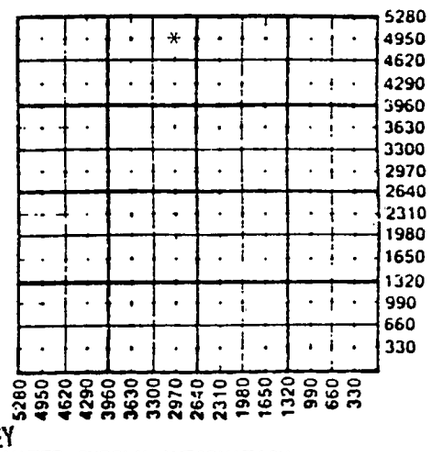

APR 0 3 1989

RECEIVED
STATE CORPORATION COMMISSION
MAR 17 1989
CONSERVATION DIVISION
Wichita, Kansas

KANSAS GEOLOGICAL SURVEY
WICHITA BRANCH

Designate Type of Completion
X New Well __ Re-Entry __ Workover

__ Oil __ SWD __ Temp Abd
X Gas ST __ Inj __ Delayed Comp.
__ Dry __ Other (Core, Water Supply etc.)

If OWWO: old well info as follows:
Operator
Well Name
Comp. Date Old Total Depth

WELL HISTORY

Drilling Method:
X Mud Rotary __ Air Rotary __ Cable

12-10-88	12-13-88	1-16-89
Spud Date	Date Reached TD	Completion Date

1370	
Total Depth	PBTD

Amount of Surface Pipe Set and Cemented at 83 feet
Multiple Stage Cementing Collar Used? __ Yes __ No
If yes, show depth set feet
If alternate 2 completion, cement circulated
from feet depth to w/ 45 SX cmt
Cement Company Name Consolidated Well Services
Invoice # 98474

WATER SUPPLY INFORMATION
Disposition of Produced Water: __ Disposal
Docket # __ Repressuring

Questions on this portion of the ACO-1 call:
Water Resources Board (913) 296-3717
Source of Water:
Division of Water Resources Permit #

__ Groundwater Ft North from Southeast Corner
(Well) Ft West from Southeast Corner of
Sec Twp Rge __ East __ West

__ Surface Water Ft North from Southeast Corner
(Stream, pond etc) Ft West from Southeast Corner
Sec Twp Rge __ East __ West

__ Other (explain)
(purchased from city, R.W.D. #)

INSTRUCTIONS: This form shall be completed in triplicate and filed with the Kansas Corporation Commission, 200 Colorado Derby Building, Wichita, Kansas 67202, within 120 days of the spud date of any well. Rule 82-3-130, 82-3-107 and 82-3-106 apply.
Information on side two of this form will be held confidential for a period of 12 months if requested in writing and submitted with the form. See rule 82-3-107 for confidentiality in excess of 12 months.
One copy of all wireline logs and drillers time log shall be attached with this form. Submit CP-4 form with all plugged wells. Submit CP-111 form with all temporarily abandoned wells.

All requirements of the statutes, rules and regulations promulgated to regulate the oil and gas industry have been fully complied with and the statements herein are complete and correct to the best of my knowledge.

Signature Dale A. Smith
Title President Date 3/15/89

Subscribed and sworn to before me this 15th day of March 19 89
Notary Public Doretta R. Juranek
Date Commission Expires April 22, 1990

DORETTA R. JURANEK
NOTARY PUBLIC
STATE OF KANSAS
MY APPT. EXPIRES 4-22-90

K.C.C. OFFICE USE ONLY
F ✓ Letter of Confidentiality Attached
C __ Wireline Log Received
C __ Drillers Timelog Received
Distribution
__ KCC __ SWD/Rep __ NGPA
✓ KGS __ Plug __ Other (Specify)

Sec. 36 Twp. 9 Rge. 21E

Form ACO-1 (5-86)