


Map No. Kansas Sec. 24 Twp. 33 R. 2E

Well No. 9 J.W. Holman Farm
Marland Company

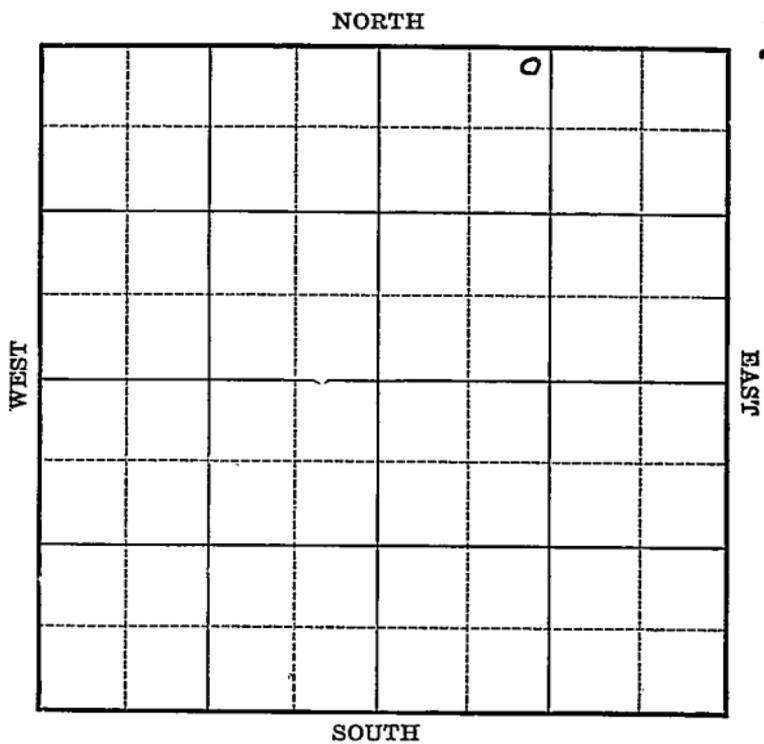

Location _____

Drilling Remarks _____

Rig Up _____

Drilling Remarks _____

RECORD

Cased _____ in. _____ ft.

Sand _____

Gas _____

Oil _____

Total Depth _____

PRODUCTION

1st 24 hrs. Nat. _____

1st 24 hrs. after shot _____

Gas _____ cu. ft.

Dry Hole _____

Abandoned _____

James Tanner

Map No. **KANSAS** Sec. *24* Twp. *33* R. *2E*

Well No. *2 J M Holman*

Masland Company

Contractor


SECTION PLAT

330 Ft. from N. Line

_____ Ft. from S. Line

_____ Ft. from E. Line

990 Ft. from W. Line

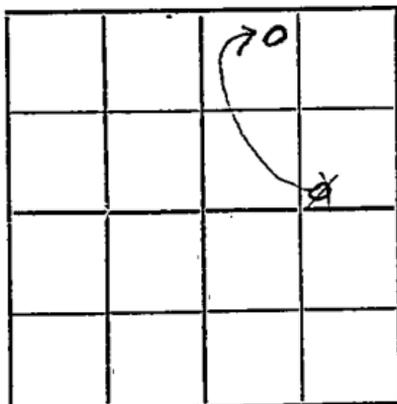

Collection.

Location _____

Rig up _____

Drilling and Remarks:

*Change No 3
to No 2. also
Change location
it was
SW-SE-NE.*

RECORD

Cased _____ in., _____ ft.

Sand _____

Gas _____

Oil _____

Total Depth _____

PRODUCTION

1st 24 hrs. Nat. _____

1st 24 hrs. after shot _____

Gas _____ Cu. Ft.

Dry Hole _____

Abandoned _____

Date

FEB 3 1922

S. J. LEWIS

Scout

Map No. **K1 KANSAS** Sec. 24 Twp. 33 R. 2E

Well No. 2. J. M. Holman

Marland Oil Company

Contractor

SECTION PLAT

330 Ft. from N. Line

_____ Ft. from S. Line

_____ Ft. from E. Line

990 Ft. from W. Line

		0	

ABANDONED

Location _____

Rig up _____

Drilling and Remarks:

TJ 8292.

I & A.

RECORD

Cased _____ in., _____ ft.

Sand _____

Gas _____

Oil _____

Total Depth _____

PRODUCTION

1st 24 hrs. Nat. _____

1st 24 hrs. after shot _____

Gas _____ Cu. Ft.

Dry Hole _____

Abandoned _____

Date

APR 20 1926

192

S. J. LEWIS

Scout

Sumner
MAP No. **K1** KANSAS SEC. *24* TWP. **33S** R. **2E**

WELL No. *407* **McClure**
McClure + Brody COMPANY

CONTRACTOR

ABANDONED

SECTION PLAT

_____ FT. FROM N. LINE

_____ FT. FROM S. LINE

_____ FT. FROM E. LINE

_____ FT. FROM W. LINE

		0.	

training work
change
NE **NWNE**

LOCATION _____

RIG UP _____

DRILLING AND REMARKS:

we show
nwne
not change

RECORD

CASED _____ IN. _____ FT.

SAND _____

GAS _____

OIL _____

TOTAL DEPTH **3292**

PRODUCTION

1ST 24 HRS. NAT. _____

1ST 24 HRS. AFTER SHOT _____

GAS _____ Cu. Ft.

DRY HOLE

ABANDONED

DATE

4/28 192**6**

SCOUT