


Summer

Map No. *1000* Sec. *24* Twp. *33* R. *2E*

Well No. *1-401* Farm _____
Carter Oil Company

NORTH

15

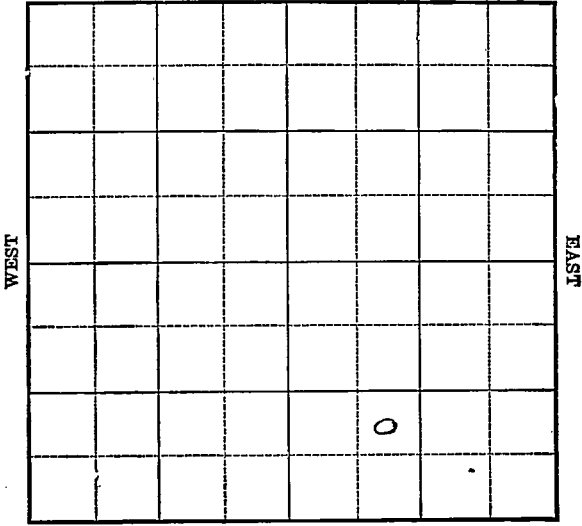

Location _____

Drilling Remarks _____

Rig Up _____

Drilling Remarks _____

RECORD

Cased _____ in. _____ ft.

Sand _____

Gas _____

Oil _____

Total Depth _____

PRODUCTION

1st 24 hrs. Nat. _____

1st 24 hrs. after shot _____

Gas _____ cu. ft.

Dry Hole _____

Abandoned _____

Map No. Kaw Sec. 24 Twp. 33 R. 2 E

Well No. 1 Holt Farm

Carter Oil Company


_____ Ft. from N. Line

990 Ft. from S. Line

_____ Ft. from E. Line

990 Ft. from W. Line

Summer

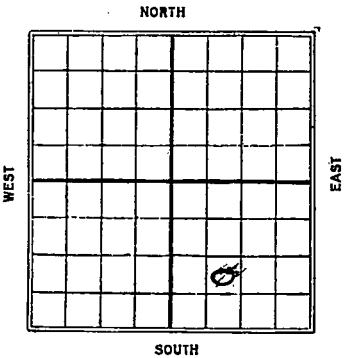

1926

Date	REPORT
9/22	Rig Bldg
9/29	rig
10/6	Spud
10/13	Drly 640
10/20	" 1375'
10/27	" 1840
11/3	" 1950'
11/10	" 2290
11/17	J.D. 2450' - W.P. 8"
11/24	Drly 2910
12/1	6" at 3021 - Drly 3055'
12/8	Drly 3230'
12/15	" 3480'
12/21	Top oil line 3655 Drly 3658
12/29	Abandoned 3670

Map No. KANSAS Sec. 24 Twp. 23 R. 2E

Well No. 1 Hold.

Carter Oil Co. Company

Contractor

SECTION PLAT

----- Ft. from N. Line

990 Ft. from S. Line

----- Ft. from E. Line

990 Ft. from W. Line

		o	

FIRST REPORTS

Location -----

Rig up -----

Drilling and Remarks:

Rig Bldg

RECORD

Cased ----- in., ----- ft.

Sand -----

Gas -----

Oil -----

Total Depth -----

PRODUCTION

1st 24 hrs. Nat. -----

1st 24 hrs. after shot -----

Gas ----- Cu. Ft.

Dry Hole -----

Abandoned -----

Date

SEP 22 1926

192

S. J. LEWIS

Scout

Map No. KANSAS Sec. 24 Twp. 33 R. 2E

Well No. 1 Ho. 18.

Coates Oil Company

Contractor

SECTION PLAT

----- Ft. from N. Line

990 Ft. from S. Line

----- Ft. from E. Line

990 Ft. from W. Line

ABANDONED

Location -----

Rig up -----

Drilling and Remarks:

TID 3670 HFW

I & A.

RECORD

Cased ----- in., ----- ft.

Sand -----

Gas -----

Oil -----

Total Depth -----

PRODUCTION

1st 24 hrs. Nat. -----

1st 24 hrs. after shot -----

Gas ----- Cu. Ft.

Dry Hole -----

Abandoned -----

Date

DEC 29 1926

S. J. LEWIS

Scout

Sumner
K1 KANSAS SEC. *24* TWP. *33S* R. *2E*

WELL No. *1 Holt*
Center COMPANY _____

CONTRACTOR _____

SECTION PLAT

ABANDONED

_____ FT. FROM N. LINE
_____ FT. FROM S. LINE
_____ FT. FROM E. LINE
_____ FT. FROM W. LINE

		0	

LOCATION _____

RIG UP _____

DRILLING AND REMARKS:

over

RECORD

CASED _____ IN. _____ FT.
SAND _____
GAS _____
OIL _____
TOTAL DEPTH *3670*

PRODUCTION

1ST 24 HRS. NAT. _____
1ST 24 HRS. AFTER SHOT _____
GAS _____ Cu. Ft.
DRY HOLE */*
ABANDONED */*

DATE *1/12* 192 *9*

SCOUT