

State Kansas County Comanche


Company Pure Oil Well No. 1

Farm Parks

Survey \_\_\_\_\_

Block No. \_\_\_\_\_ Sec. 32 Twp. 33 Range 17W

Co-Ord. Sw Sw Se Elev. 1856 DF  
1856 DA

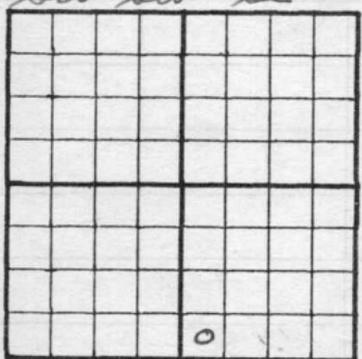

NOTE: Show Sketch of Lease and Well Location in Above Space

Ft. from N. Line \_\_\_\_\_ Ft. from S. Line \_\_\_\_\_  
Ft. from W. Line \_\_\_\_\_ Ft. from E. Line \_\_\_\_\_

| Date | Depth       |                                 |
|------|-------------|---------------------------------|
|      | 4315        | K.C. (-2459)                    |
|      | Net 4352-95 | ops 45" Gas in 1 1/2"           |
|      |             | DN 20" G. 200,000 cy. 2 3/8"    |
|      |             | Rec 85' DCM. 70% dist           |
|      |             | IF-605, FF-785, BHP 1689/20"    |
|      | Net 4506-45 | ops 1 hr. gas in 1 1/2" 500,000 |
|      |             | Rec 120' SGCM. IF+FF-68         |
|      |             | Bhp-1762/20"                    |
|      | 4872        | Marmaton (-3016)                |

717723

| Date | Depth         |  |
|------|---------------|--|
|      | Dst 4893-4927 | Gas in 1 1/2". <sup>1" op</sup> In 45"   |
|      |               | 1,095,000. Rec 90' gcm.                  |
|      |               | IF-180, FF-190, BHP 1800/20"             |
|      | 5010          | Miss (-3154)                             |
|      | Dst 5020-5110 | Gas in 2" <sup>1" op</sup> In 10"        |
|      |               | 885,000, In 25" 865,000, In              |
|      |               | 30" 845,000 In 50" 820,000               |
|      |               | Rec 200' gcm.                            |
|      |               | IF-130, FF-165, BHP-1810/20"             |
| 3-20 | 5275          | Dreg (43' higher on Miss than #1 Beales) |
| 3-26 | 5554          | Vises (-3695)                            |
|      | 5656          | "Slip Sd (-3797)                         |
|      | Dst           | Dip 10' sand                             |
|      |               | 8,940,000. Rec 50' dist                  |
|      |               | Jf-2038, Jf-2012, Bhp-2158               |
|      |               | 17% por Rec 500 miles                    |
|      |               | with 31%                                 |
|      |               | (80' higher than #1 Beales)              |