




Summer

Map No. Kansas Sec. 24 Twp. 33 R. 2 E

Well No. 2 Holch Farm

Phillips Pet Company

NORTH

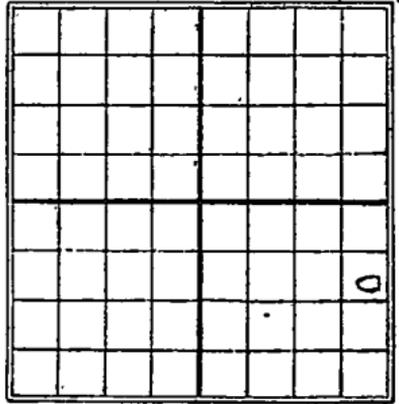

990 Ft. from N. Line

\_\_\_\_\_ Ft. from S. Line

330 Ft. from E. Line

\_\_\_\_\_ Ft. from W. Line

Date

REPORT

1925

9/30 Location

10/6 Rig

10/13 \_\_\_\_\_

10/21 \_\_\_\_\_

10/28 \_\_\_\_\_

11/4 \_\_\_\_\_

11/18 \_\_\_\_\_

~~1926~~

4/7 3211 O.G. 3214 2 1/2 m

Gas T.D. 3229

350 bbls mol

59 gts 438 bbls

39 Gravity

*Summer*  
 Map No. **KANSAS** Sec. *24* Twp. *33* R. *2E*

Well No. *2 Hold*

*Phillips P. & C.* Company  
 Contractor

**SECTION PLAT**

*990* Ft. from N. Line

\_\_\_\_\_ Ft. from S. Line

*330* Ft. from E. Line

\_\_\_\_\_ Ft. from W. Line

			0

**FIRST REPORT**

Location \_\_\_\_\_

Rig up \_\_\_\_\_

Drilling and Remarks:

*Location.*

**RECORD**

Cased \_\_\_\_\_ in., \_\_\_\_\_ ft.

Sand \_\_\_\_\_

Gas \_\_\_\_\_

Oil \_\_\_\_\_

Total Depth \_\_\_\_\_

**PRODUCTION**

1st 24 hrs. Nat. \_\_\_\_\_

1st 24 hrs. after shot \_\_\_\_\_

Gas \_\_\_\_\_ Cu. Ft.

Dry Hole \_\_\_\_\_

Abandoned \_\_\_\_\_

Date

**SEP 30 1925**

**S. J. LEWIS**

192

Scout

Map No. Sumner **KANSAS** Sec. 24 Twp. 33 R. 25

Well No. 2 Holt

Phillips Pet. Company

Contractor

**SECTION PLAT**

990 Ft. from N. Line

\_\_\_\_\_ Ft. from S. Line

380 Ft. from E. Line

\_\_\_\_\_ Ft. from W. Line

			0

**COMPLETED**

Location \_\_\_\_\_

Rig up \_\_\_\_\_

Drilling and Remarks:

78.3211  
089.3214 - 2 1/2 M. Gas.  
7113229  
350 8/16 Nat.  
312859 to  
438 8/16. 37 1/2 G.

**RECORD**

Cased \_\_\_\_\_ in., \_\_\_\_\_ ft.

Sand \_\_\_\_\_

Gas \_\_\_\_\_

Oil \_\_\_\_\_

Total Depth \_\_\_\_\_

**PRODUCTION**

1st 24 hrs. Nat. \_\_\_\_\_

1st 24 hrs. after shot \_\_\_\_\_

Gas \_\_\_\_\_ Cu. Ft.

Dry Hole \_\_\_\_\_

Abandoned \_\_\_\_\_

Date

APR 7 1926

S. J. LEWIS

Scout