


*Summer*

Map No. *171* Sec. *24* Twp. *33* R. *2E*

Well No. *3 Bolt* Farm \_\_\_\_\_

*Sinclair O & G* Company \_\_\_\_\_

NORTH

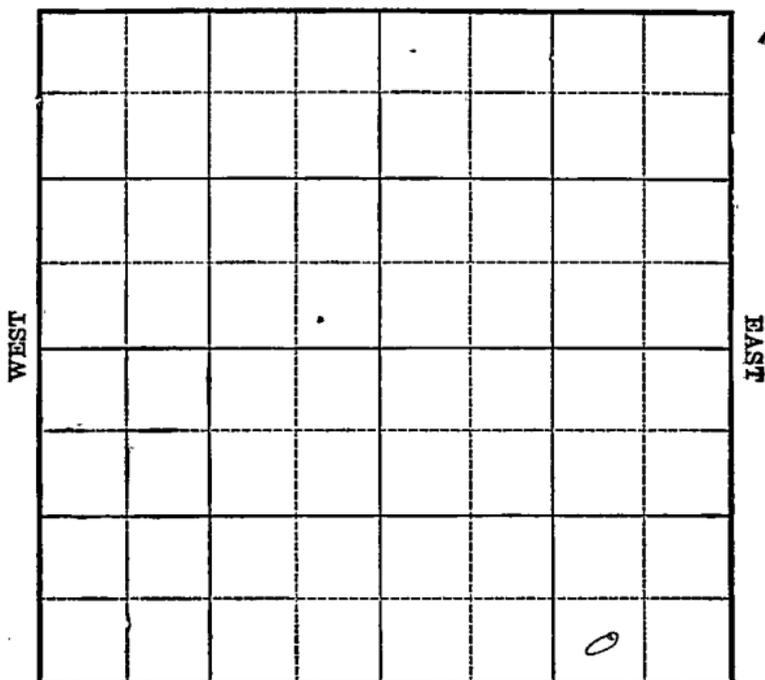

*16*

SOUTH

Location \_\_\_\_\_

Drilling Remarks \_\_\_\_\_  
\_\_\_\_\_  
\_\_\_\_\_  
Rig Up \_\_\_\_\_

Drilling Remarks \_\_\_\_\_  
\_\_\_\_\_  
\_\_\_\_\_  
**RECORD**

Cased \_\_\_\_\_ in. \_\_\_\_\_ ft.

Sand \_\_\_\_\_

Gas \_\_\_\_\_

Oil \_\_\_\_\_

Total Depth \_\_\_\_\_

**PRODUCTION**

1st 24 hrs. Nat. \_\_\_\_\_

1st 24 hrs. after shot \_\_\_\_\_

Gas \_\_\_\_\_ cu. ft.

Dry Hole \_\_\_\_\_

Abandoned \_\_\_\_\_

Summer Co

Map No. Kansas Sec. 24 Twp. 33 R 2 E


Well No. 3 Holt Farm  
Shinclair O. & G. Company

..... Ft. from N. Line

300 Ft. from S. Line

990 Ft. from E. Line

..... Ft. from W. Line

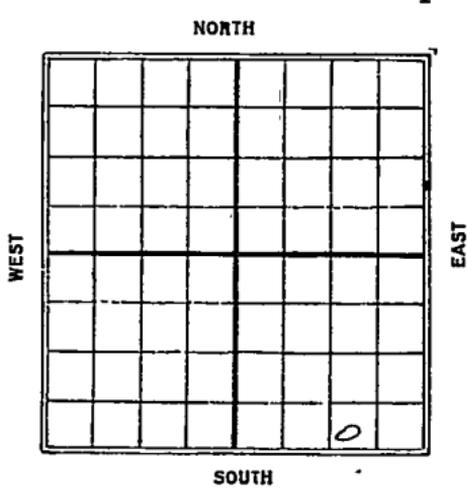

Date	REPORT
1926	
8/18	Location
8/25	rog
9/1	rig
9/8	rigging up
9/15	Spud
9/22	Drlg 65-5-
9/29	" 750
10/6	no report
10/13	Drlg 980
10/20	T.D. 2312-URS"
10/27	drlg 2735-
11/3	" 2735-
11/10	Running 6" at 3020
11/17	Top line 3235-
	Drlg 3250
11/24	Drlg 3535
12/18	Wilcox 3532' to 3542'
	Sil line: 3561'-63'
	T. D. 3563'- 640 bbls. 24 hrs.

*Summer*  
 Map No. **KANSAS** Sec. *24* Twp. *33* R. *2E*

Well No. *3 Holt*

*Sinclair O & G.* Company

Contractor

**SECTION PLAT**

			0

----- Ft. from N. Line

*300* Ft. from S. Line

*990* Ft. from E. Line

----- Ft. from W. Line

**FIRST REPORTS**

Location -----

Rig up -----

Drilling and Remarks:

*Location*

**RECORD**

Cased ----- in., ----- ft.

Sand -----

Gas -----

Oil -----

Total Depth -----

**PRODUCTION**

1st 24 hrs. Nat. -----

1st 24 hrs. after shot -----

Gas ----- Cu. Ft.

Dry Hole -----

Abandoned -----

Date

**AUG 18 1926**  
 ----- 1926

**S. J. LEWIS**  
 ----- Scout

Map No. KANSAS Sec. 24 Twp. 33 R. 2E

Well No. 3 Hold

Senclair O & G Company

Contractor

SECTION PLAT

----- Ft. from N. Line

300 Ft. from S. Line

990 Ft. from E. Line

----- Ft. from W. Line

			0

**COMPLETED**

Location -----

Rig up -----

Drilling and Remarks:

Wilcox 3532 & 3542.  
Silvina 3561-63  
7113563.  
640886-24 hrs

RECORD

Cased ----- in., ----- ft.

Sand -----

Gas -----

Oil -----

Total Depth -----

PRODUCTION

1st 24 hrs. Nat. -----

1st 24 hrs. after shot -----

Gas ----- Cu. Ft.

Dry Hole -----

Abandoned -----

Date

DEC 8 - 1926

S. J. LEWIS