

Section 25 Township 33 Range 2 E

Well No. # 1 Swain

Company Bowman & Grismore

2

NORTH

					0		

WEST

EAST

SOUTH

Sec. 25 Twp. 33 R. 2E

Well No. #1 Swain Farm

Bowman & Grismore Company

Greeley Drlg. Contractor

Rainbow Bend Pool


990 Ft. from N. Line

_____ Ft. from S. Line

_____ Ft. from E. Line

990 Ft. from W. Line

SE NW NE

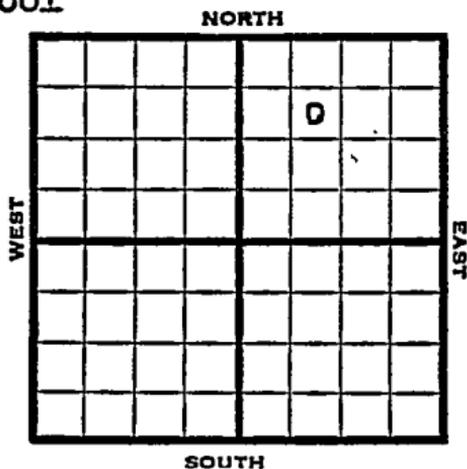

1953 Elev. 1105' REPORT

5/20 Spud 5-15-53
8" @ 90'
Drlg 700'
TITE HOLE UNTIL COMP.

7/29 Spud 5-15-53
Oil Well
TD 3228
8" @ 90
Stal 2165, Layton 2560, KC 2734,
Oswego 2922, Bart 3205, Miss 3213
DST 3220-28, opn 1 hr., rec. 8' mud,
O#
TD 3228, 5" @ 3222, 9/3224-28
sd-frac
Comp. 10 bopd

COMPLETED

County Sumner State Kansas

Sec. 25 (Blk. 33) (Sur. 2E) (Twp.) (Rge.) Map No.

Operator Bowman & Grismore

Well No. 1 Farm Swain

Elev. 1105 Location SE NW NE

990 Ft. From N Line NE

990 Ft. From W Line Quarter

1st. Report

JUL 29 1953

Completion

Remarks Rainbow Bend Pool

Greeley Drlg. - Contr.

Spudding Date 5-15-53

Drlg. Data Oil well TD 3228

8" @ 90 Stal. 2165 Layton 2560

KC 2734 Oswego 2922 Bart. 3205

Miss. 3213 DST 3220-28 open 1 hr.

Rec. 8' mud 0# TD 3228 5" @ 3222

9/ 3224-28 sd-frac Comp. 10 bopd

J. G. McGEHEE