


Section 15 Township 18 Range 9W

Well No. 2 Staatz

Company Beardmore Drlg.

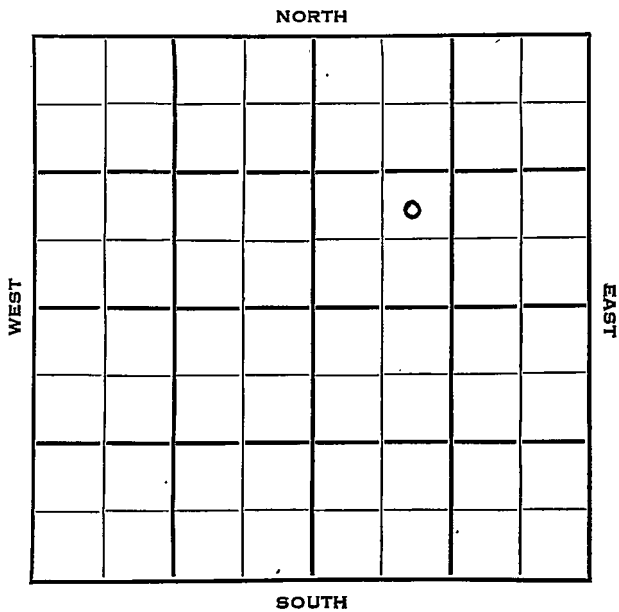

Rice

KANSAS

SEC. 15	TWP. 18	R. 9W	✓
------------	------------	----------	---

WELL NO. #2 Staatz FARM
COMPANY

CONTRACTOR Beardmore Drlg.

Beardmore Drlg.


Staatz Pool

_____ Ft. from N. Line

990 _____ Ft. from S. Line

_____ Ft. from E. Line

990 _____ Ft. from W. Line

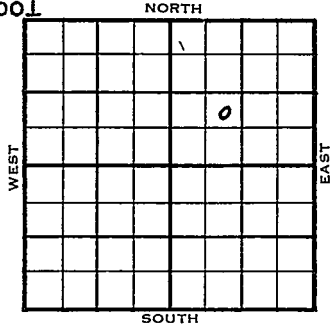

NE SW NE

1954	ELEVATION 1743'	REPORT
------	--------------------	--------

2/24 Spud 2-18-54
8" @ 187'
Drlg 2768'

3/3 Spud 2-18-54
D & A
TD 3320'
8" @ 187'
Heeb 2740'; Br. Lime 2868', Lans 2891'
Cong 3248', Simp Sh 3253', Simp Sd 3260
DST 3260'-67' opn 1 hr, rec 85' g & ocm
90' gcsw 780#
Arb 3305'
TD 3320'
D & A

ABANDONED

