


Rice

KANSAS

SECTION 15 TOWNSHIP 18 RANGE 9^W

WELL NO. #4 Staatz

COMPANY Beardmore

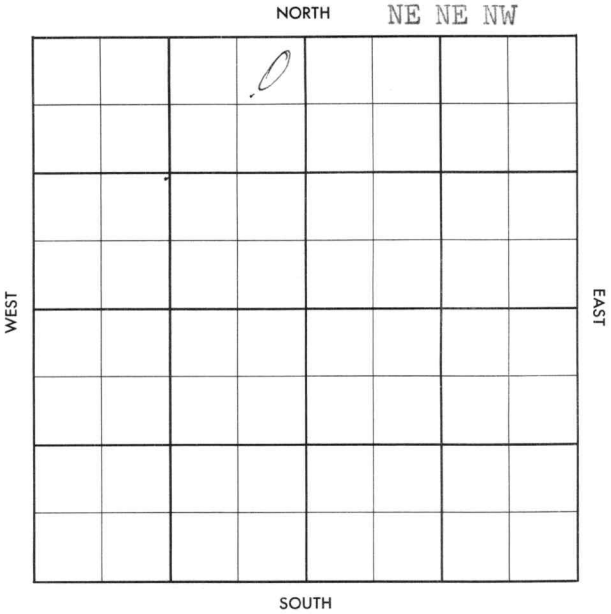

County Rice Elev. _____
 Sec. 15 Twp. 18 Rgs. 9W
 Company Beardmore
 Farm Name Staatz No. 4

TOPS	DEPTH	LOG	DATUM	Loc. in Sec.
Anh.				NE NE NW
Tp.				
H.				
Tr.				
Dg.				
Bl.				
L.				Geol. _____
K.C.				Contr. _____
B.K.C.				
Ce.				<u>Beardmore</u>
C.				
M.				Pool _____
M.				<u>Staatz</u>
K.				
Mz.				
Me.				
V.				
S.				
S.				
A.				
R.				
Pe.				
G.				
T.D.				

0

FIRST REPORT

MAY 8 57

Date Comm. M I R

[Handwritten signature]

Co. Lse. No. Sec. T. R.

County Rice Elev. 1738
 Sec. 15 Twp. 18 Rge. 9W
 Company Beardmore
 Farm Name Staatz No. 4

TOPS	DEPTH	LOG	DATUM	Loc. in Sec.
Anh.				NE NE NW
T.P.				
H.	2738			
Tr.				
Dg.				
BL.	2862			
L.	2886			Geol.
K.C.				
B.K.C.				Contr.
Ce.				Beardmore
C. <u>sd</u>	3231			
M.				Pool
M.				Staatz
K.				
Mz.				
Ma.				
V.				
S.				
S.				
A.				
R.				
PE.				
G.				
TD.	3240			

o

JUL 17 57

COMPLETE

Date Comm. M I R MAY 15 '57 MAY 22 '57 5-14-57 808
209 # 3106 MAY 29 '57 CID 3231-24
see 3' DST 3214-34 1hr
2650' GIR see 1200' oil 344
980/20" 5 1/2 3232/50 JUN 5 '57
co 3240 TD FU 2700' oil 12
ms & 7 Boph 2250' o.B
now PD 3242 TD FU 3000
oil now T&K JUN 12 '57 JUN 19 '57 JUN 20 '57
JUL 5 '57 JUL 10 '57 JUL 17 '57 P. 125 Bopd no/w