


KANSAS

Rice County

Section 16 Township 18 Range 9W

Well No. #1 Murphy

Company Transwestern

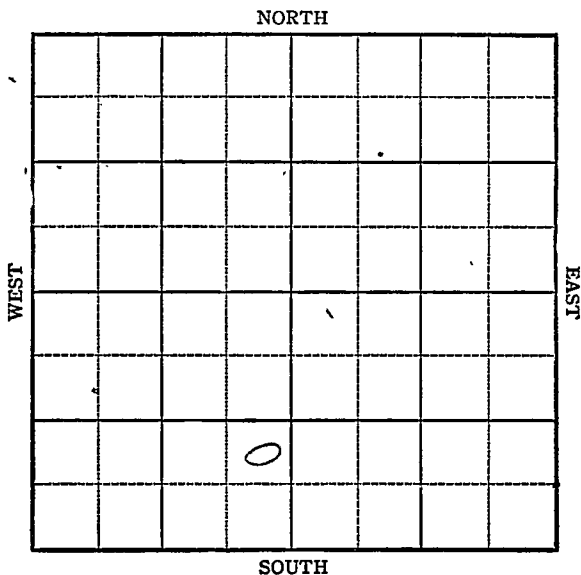

KANSAS

Rice County

Sec. 16 Twp. 18 R. 9W

Well No. #1 Murphy Farm _____

Transwestern Company


Wildcat

_____ Ft. from N. Line

990 Ft. from S. Line

330 Ft. from E. Line

_____ Ft. from W. Line

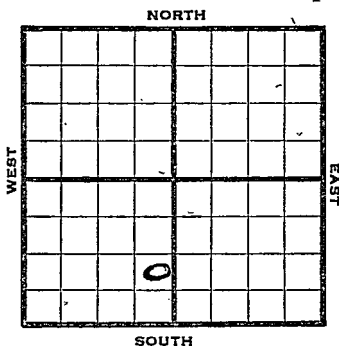

NE SE SW

1944

R E P O R T

10/18 Drlg. 270'

10/25 8" @ 270
Anhy 400
Drlg. 2702

11/1 Lans 2898
Cong. 3193
Arb 3276
TD 3309'

ABANDONED

