
FORM 51 25M 3-49 PETROL

Rice KANSAS

Section 18 Township 18 Range 9W

Well No. #1 Habiger

Company Don Ingling

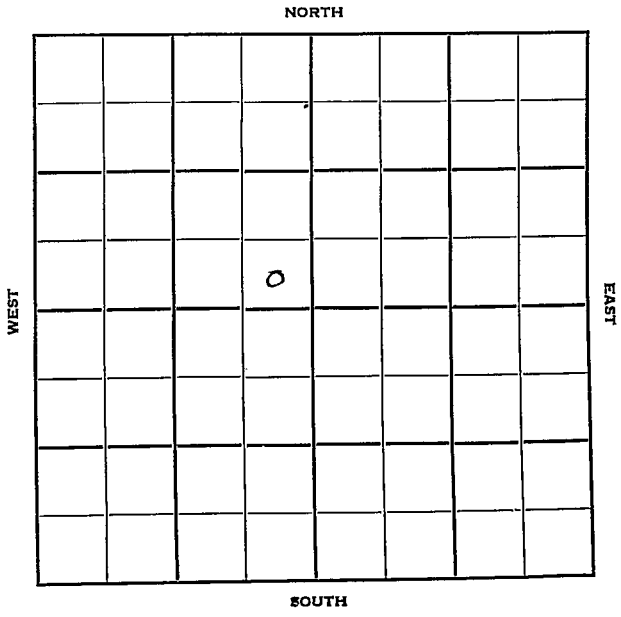

FORM 252-B
10M 9-49 PETROL

Rice KANSAS

Sec. 18 Twp. 18 R. 9W

Well No. #1 Habiger Farm

Don Ingling Company

Contractor

Wildcat


Ft. from N. Line

330' Ft. from S. Line

330' Ft. from E. Line

Ft. from W. Line

SE SE NW

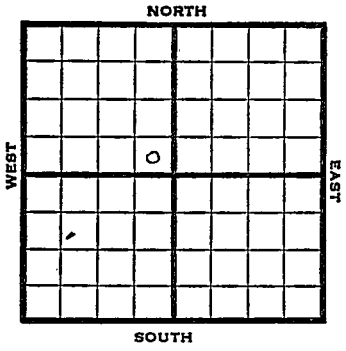

1950	Elev 1727' REPORT
3/15	Spud 3-11-50 8-5/8" @ 192' WOC
4/12	TD 3233' 8 5/8" @ 192' Arb. 3214' 5½" @ 3216' Plug back to 3232' D&A Aband.

ABANDONED

Form 26 200 Bks. 11-49 Petrol Kansas Wildcat

Map No. _____ Sec. 18 Twp. 18 R. 9W


Well No. 1 Habiger

Don Ingling Company

Contractor

SE SE NW

SECTION PLAT

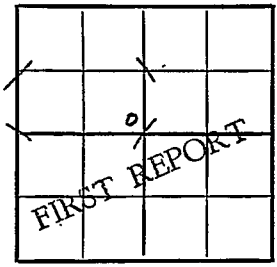

_____ Ft. from N. Line

330 Ft. from S. Line

330 Ft. from E. Line

_____ Ft. from W. Line

Rice County

Location _____

Rig up _____

Drilling and Remarks:

Spud 3-11-50

8 5/8" @ 192

WOC

RECORD

Cased _____ in., _____ ft.

Sand _____

Gas _____

Oil _____

Total Depth _____

PRODUCTION

1st 24 hrs. Nat. _____

1st 24 hrs. after shot _____

Gas _____ Cu. Ft.

Dry Hole _____

Abandoned _____

Date

MAR 15 1950 19 J. E. TYRA Sec

Form 26 200 Bks. 11-49 Petrol

Kansas Wildcat

Map No. ____ Sec. 18 Twp. 18 R. 9W

Well No. 1 Habiger


Don Ingling Company

Contractor

SE SE NW

El 1727

SECTION PLAT

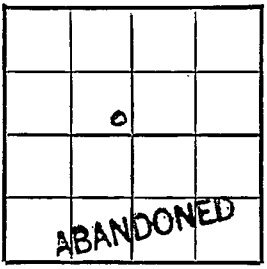

____ Ft. from N. Line

330 Ft. from S. Line

330 Ft. from E. Line

____ Ft. from W. Line

Rice County

Location ____

Rig up ____

Drilling and Remarks:

8 5/8" @ 192
and 3214
5 1/2" @ 3216
Plug back to 3232
D & A.

RECORD

Cased ____ in., ____ ft.

Sand ____

Gas ____

Oil ____

Total Depth 3233

PRODUCTION

1st 24 hrs. Nat. ____

1st 24 hrs. after shot ____

Gas ____ Cu. Ft.

Dry Hole ____

Abandoned ____

Date

APR 12 1950

19

J. E. TYRA

Scout