Rice KANSAS

18 18S 9W


SECTION TOWNSHIP RANGE

#1 Habiger "A"

WELL NO.

Bennett & Roberts

COMPANY

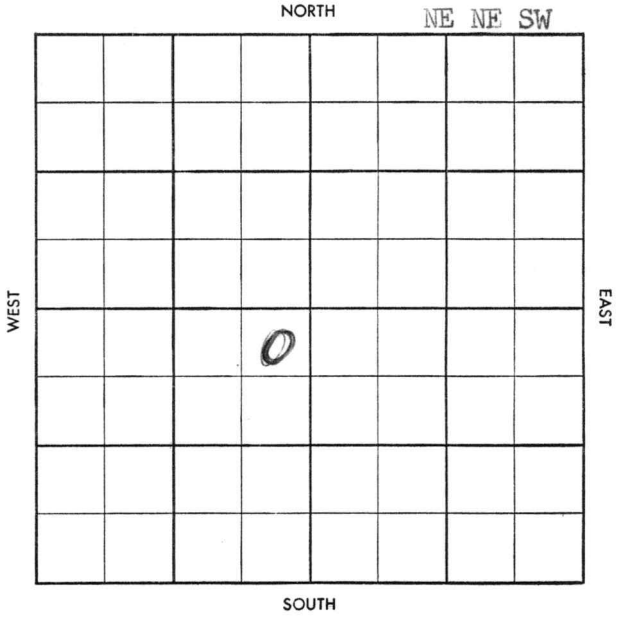

FORM 504-3 SUNRAY

S-513-A

CO. Rice ELEV.

SEC. 18 TWP. 18 RGE. 9W

COMPANY Bennett & Roberts NO. 1

FARM Habiger "A"

LOC. NE NE SW

GEOL.

CONTR. Co. tools

POOL N. Farmer

SPUD 11-8-57

8" @ 253/175

drlg. 1865

FIRST REPORT

NOV 13 57

CO. LSE. NO. SEC. TWP. RGE.

12

S-513-A

CO. Rice ELEV. 1726DF

SEC. 18 TWP. 18 RGE. 9W

COMPANY Bennett & Roberts NO. 1

FARM Habiger "A"

LOC. NE NE SW

COMPLETE

DEC 1 1 57

GEOL.

CONTR. Co. tools

POOL N. Farmer

SPUD 11-0-57

8" @ 253/175

drlg. 1665

NOV

Hb2732 TR

2750 BL 2854

L 2875 Ab

3211 RTD 3215

5½" 3213 DST 2665-2701

60" 40' W BHP 970 WOCT

CP DD3246 TD 200A

$4BO Dk NW FU 1425 oil

10h-s POP DEC 4 57 X

25 BO Pd MW

Arb open Nak 3213-3216

CO. LSE. NO. SEC. TWP. RGE.