
Rice KANSAS

SECTION 18 TOWNSHIP 18 RANGE 9W

WELL NO. #1 Dell

COMPANY Bennett & Roberts

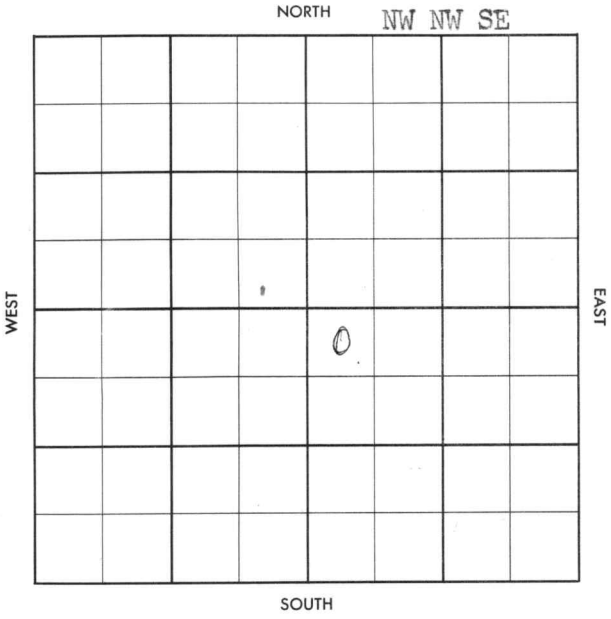

FORM 504-3 SUNRAY

WILDCAT

FORM 513 SUNRAY

County Rice Elev.

Sec. 18 Twp. 18 Rge. 9W

Company Bennett & Roberts

Farm Name Doll No. 1

TOPS	DEPTH	LOG	DATUM
Anh.			
T.P.			
H.			
Tr.			
Dg.			
B.L.			
L.			
K.C.			
B.K.C.			
Ce.			
C.			
M.			
M.			
K.			
Mz.			
Mq.			
V.			
S.			
S.			
A			
R.			
P€.			
G.			
T.D.			

Loc. in Sec. NW NW SE

Geol.

Contr. Co. tools

Pool Wildcat

FIRST REPORT

FEB 27 '57

Date Comm. 2-22-57

8" @ 232/175 drlg. 1770

T2

Co. Lse. No. Sec. T. R.

FORM 513 SUNRAY

County Rice Elev. 1726 DF

Sec. 18 Twp. 18 Rge. 9W

Company Bennett & Roberts

Farm Name Bell No. 1

TOPS	DEPTH	LOG	DATUM
Anh.			
Tp.			
H.	2735		
Tr.	2769		
Dg.			
Bl.			
L.	2886		
K.C.			
B.K.C.			
Ce.			
C.	3202		
M.			
M.			
K.			
Mz.			
Mo.			
V.			
S.			
S.			
A	3223		
R.			
Pe.			
G.			
T.D.	3232		

Loc. in Sec. NW NW SE

Geol.

Contr. / Co. tools

Pool Wildcat

COMPLETE

MAY 1 '57

Date Comm. 2-22-57

8" @ 232/175 drlg. 1770 MAR 6 '57

DST 3223-32 RTH op 2 hrs

rec 90' Mdy oil Bltt 1000/30"

5½ @ 3226/125 MAR 13 '57 DP 3232

$ 18 6 OPH /4 hrs tot MAR 20 '57

APR 27 '57 APR 3 '57 APR 10 '57 135 gal acid

POP P. 18 BOPD no wtr

APR 17 '57 APR 24 '57 MAY 1 '57 P. 20 BOPD

no wtr est 32.9°

Co. Lse. No. Sec. T. R.