


Section 19 Township 18 Range 9W

Well No. #4 Matthaei

Company Nadel & Gussman

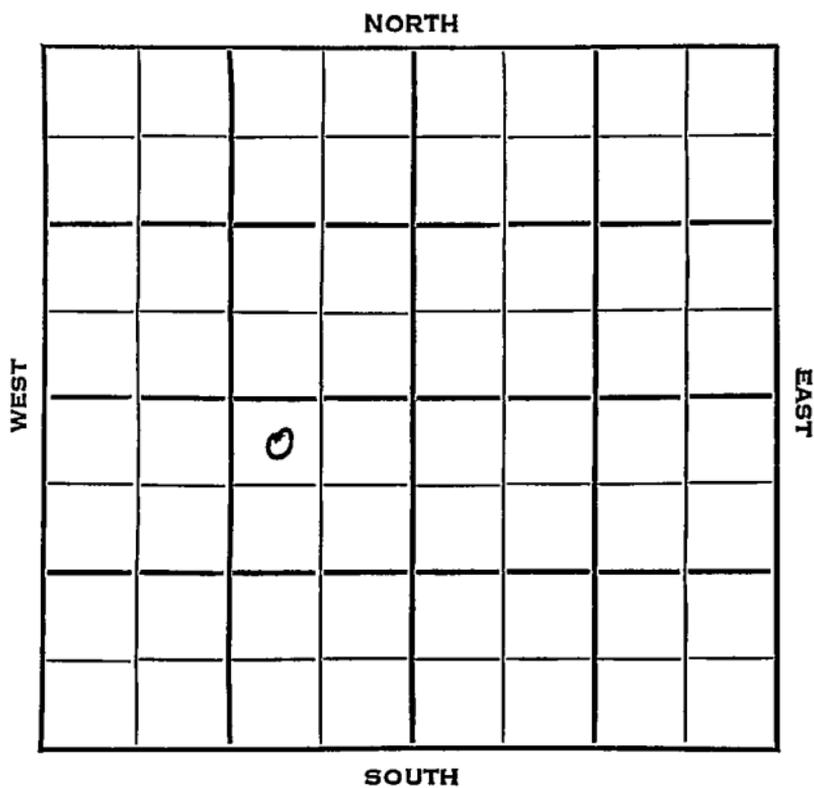

Rice

KANSAS
9W

Sec. 19 Twp. 18 R. 9W

Well No. #4 Matthaei Farm

Nadel & Gussman Company

Reserve Drlg. Contractor

Farmer Pool


330 Ft. from N. Line

Ft. from S. Line

990 Ft. from E. Line

Ft. from W. Line

NW NE SW

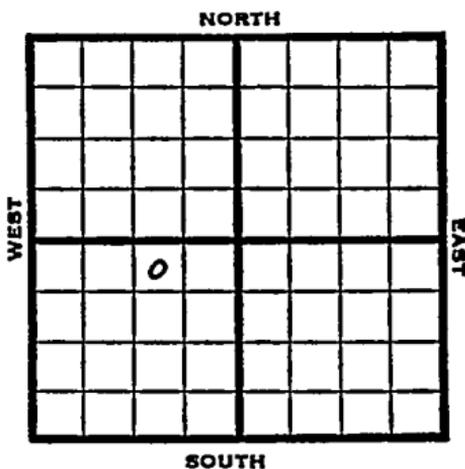

1953 Elev. 1722' REPORT

8/19 Spud 8-14-53
8" @ 165'
Drlg 2180'

8/26 Heeb 2728' Br Lime 2851' Lans 2875'
Arb. 3214' RTD 3225'
5" @ 3223'

9/2 DD

9/9 3227 TD
1000 A S/ 35 boph 3 hrs. POP.

9/16 NR

9/23 Spud 8-14-53
Oil Well
TD 3227'
8" @ 165'
Heeb. 2728', Br. Lime 2851', Lans 2875'
Arb 3214'
TD 3225'
5" @ 3223'
CO to 3225 DD 3227 - 1000 A
S/ 35 boph
Comp. 170 bopd.

COMPLETED

