

Trego


KANSAS

SECTION 2 TOWNSHIP 12 RANGE 23W

WELL NO. #4 Hixson "D"

COMPANY Imperial Oil Co.

NORTH C E/2 NW SE

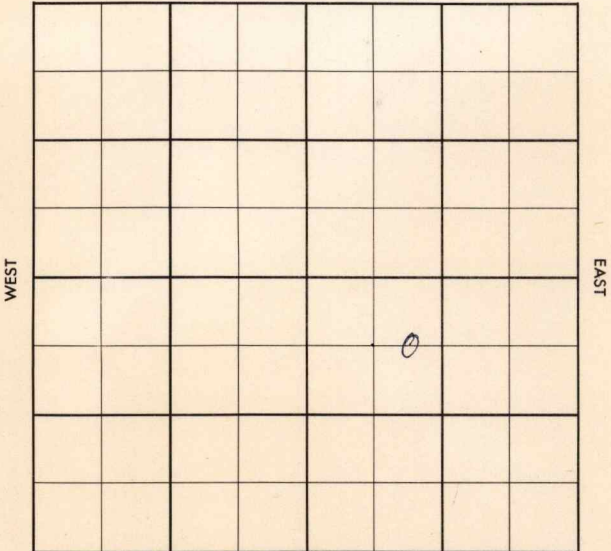

SOUTH

County Trego Elev. _____
 Sec. 2 Twp. 12 Rge. 23W
 Company Imperial Oil Co.
 Farm Name Hixson "D" No. 4

TOPS	DEPTH	LOG	DATUM
Anh.			
Tp.			
H.			
Tr.			
Dg.			
Bl.			
L.			
K.C.			
B.K.C.			
Ce.			
C.			
M.			
M.			
K.			
Mz.			
Mq.			
V.			
S.			
S.			
A.			
R.			
Pe.			
G.			
T.D.			

Loc. in Sec. C E/2 NW SE
 Geol. _____
 Contr. _____
 Co. Tools _____
 Pool _____
 Newcomer _____

MAR 5 1957
 FIRST REPORT

Date Comm. M I R T

~~5~~

Co.
Lsc.
No.
Sec.
T.
R.

County Trego Elev. 2419
 Sec. 2 Twp. 12 Rgs. 23W
 Company Imperial Oil Co.
 Farm Name Hixson "D" No. 4

TOPS	DEPTH	LOG	DATUM	Loc. in Sec.
Anh.	1834			C E/2 NW SE
Tp.				
H.	3635			
Tr.	3654			
Dg.				
Bl.				
L.	3667			
K.C.				Geol.
B.K.C.				Contr.
Ce.				Co. Tools
C.				
M.				Pool
M.				Newcomer
K.				
Mz.				
Me.				
V.				
S.				
S.				
A.				
R.				
PE.				
G.				
TD	3900			MAR 20 '57

ABANDONED
 MAR 20 '57

Date Comm. M I R T MAR 13 '57 Spd 3-5-57 8 1/2 195/50
DST 3641 -65 MAR 20 '57 40" net
5' Md BHP 510 DST 3696-3717
2 hrs net 105' SW BHP 460/20
DST 3735-50 1 hr net 30'
Md BHP 640/20 DST 3747
-58 1 hr net 15' Md BHP
560/20
 DCA