


DX 78-1 **Q** Trego

KANSAS

Section 11 Township 12 Range 23W

Well No. #2 Hixson

Company O. A. Sutton

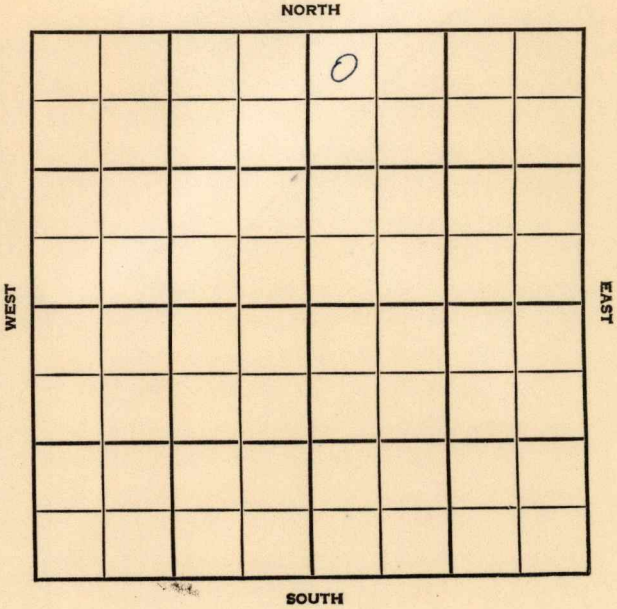

Trego

KANSAS

SEC.

11

TWP.

12

R.

23W

WELL NO.

#2 Hixson

FARM

COMPANY

O.A. Sutton

CONTRACTOR

Gabbert-Jones

NW Newcomer


_____ FT. FROM N. LINE

_____ FT. FROM S. LINE

_____ FT. FROM E. LINE

_____ FT. FROM W. LINE

NW NW NE

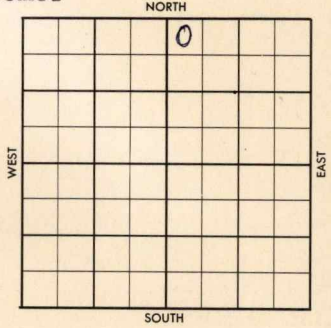

ELEVATION

1956

REPORT

7-25

Location

County Trego Elev. 2425
 Sec. 11 Twp. 12 Rge. 23W
 Company C. A. Sutton
 Farm Name Hixson No. 2

TOPS	DEPTH	LOG	DATUM	Loc. in Sec.									
Anh.	1850			NW NW 21									
Tr.													
H.	3636												
Tr.	3654												
Dg.				Geol.									
Bl.													
L.	3668			Contr.									
K.C.													
B.K.C.				Gabbert-Jone									
Ce.													
C.				Pool									
M.													
M.				NW Newcomer									
K.													
Mz.				<table border="1"> <tr> <td></td> <td></td> <td></td> </tr> <tr> <td></td> <td>31</td> <td>56</td> </tr> <tr> <td></td> <td></td> <td></td> </tr> </table>					31	56			
	31	56											
Me.				COMPLETE									
V.													
S.													
S.													
A.													
R.													
PE.													
G.													
T.D.	3883												

Date Comm. _____
 Location AUG 1 '56 7-25-56 85/8
 128/135 @ 3266 AUG 8 '56
 DST 3664-80 90" rec 245' GIP
 + 30' HOC GCM + 205' MSW BHP
 1260/60" DST 3696-3725 1hr
 rec 420' O&E HOCM + 240' GCM
 oil + TR. wts + 120' gssy oil +
 60' OCW BHP 1240/20" DST 3731
 -45 1hr 9/50" rec 535' Frqy oil

1160/20 DST 3748-60 1hr
 see 1900' SW BHP 1140/20"
 DST 3764-74 90" see 130'
 SW BHP 1160 Rng Pipe

AUG 15 '56 5 1/2 @ 3800/ AUG 22 '56

AUG 29 '56 SEP 5 '56 co 3783 16/3738

-42 +st 5 Boph. nat 1 1/2 \$
 34 Boph 5% wtu LW Plg
 @ 3720 20/3705-10 \$ 25 6oph
 Tr wtu 13 hrs 1 1/2 \$ 20 BFph
 30% wtu 600' 0.73 SEP 12 '56 T & R

SEP 19 '56 SEP 26 '56 OCT 3 '56 OCT 10 '56 OCT 17 '56 OCT 24 '56

OCT 31 '56 Ph P. 124 Bopd +
 50% wtu.