


Section 25 Township 33 Range 2E

Well No. #1 Smith WARD

Company Orville Parker

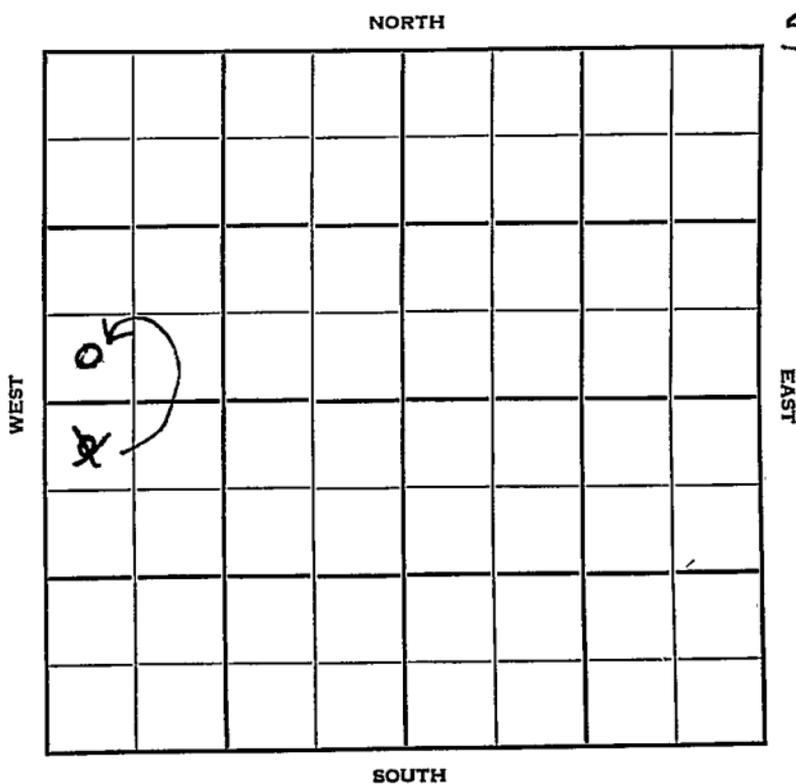

Summer

KANSAS



Sec. 25 Twp. 33 R. 2E

Well No. ~~#1 Smith~~ #1 WARD Farm

Orville Parker Company

Contractor

Rainbow Bend Pool


~~330~~ Ft. from N. Line

330 Ft. from S. Line

\_\_\_\_\_ Ft. from E. Line

330 Ft. from W. Line

~~NW NW SW~~  
Sw Sw NW

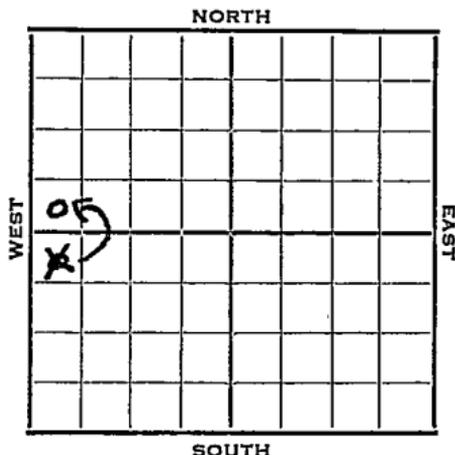

1952

Elev. 1141' REPORT

10/15

Set Surface

10/29

D&A TD 3335'

Stal. 2279

DST 2859-80 open 45 min. rec. 75' mud

Layton 2696

KC 2845

Oswego 3025

Cherokee 3160

Cattlemen sd 3241 Sd 3241

Bart 3297

Miss. 3317

DST 3317-35 open 1 1/2 hr. rec. 78'

VSOCM 525# D&A

**ABANDONED**



Kansas

Map No. \_\_\_\_\_ Sec. 25 Twp. 33 R. 2E

Well No. 1 Ward

Orville Parker Company

CORRECTION Contractor

SW SW NW


SECTION PLAT

\_\_\_\_\_ Ft. from N. Line

330 Ft. from S. Line

\_\_\_\_\_ Ft. from E. Line

330 Ft. from W. Line

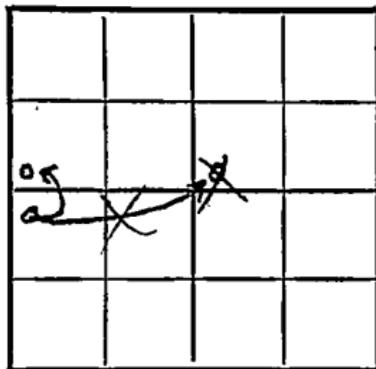

*Summer*

Location \_\_\_\_\_

Rig up \_\_\_\_\_

Drilling and Remarks:

Reported

#1 Smith

NW NW SW

RECORD

Cased \_\_\_\_\_ in., \_\_\_\_\_ ft.

Sand \_\_\_\_\_

Gas \_\_\_\_\_

Oil \_\_\_\_\_

Total Depth \_\_\_\_\_

PRODUCTION

1st 24 hrs. Nat. \_\_\_\_\_

1st 24 hrs. after shot \_\_\_\_\_

Gas \_\_\_\_\_ Cu. Ft.

Dry Hole \_\_\_\_\_

Abandoned \_\_\_\_\_

Date

OCT 22 1959

J. G. McGEHEE

Scout

