

Summer

KANSAS

SECTION 26 TOWNSHIP 33 RANGE 2 E


WELL NO. #1 Holman

COMPANY Rex & Morris & Franco Central

NORTH

WEST

EAST

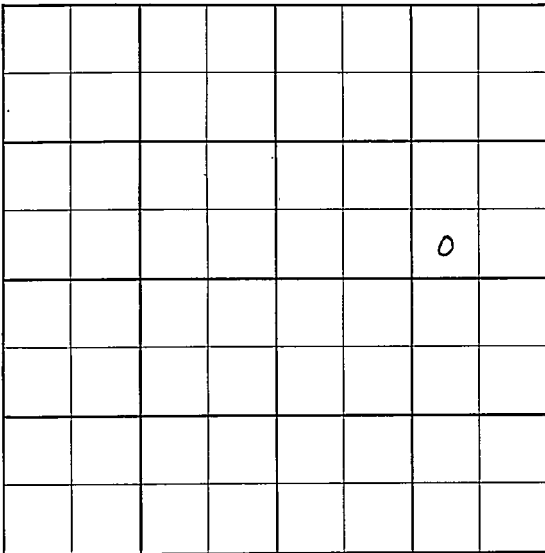

						0	

SOUTH

Summer

KANSAS

SEC.	TWP.	R.
26	33	## 2E

WELL NO.

#1 Holman

FARM

COMPANY

Rex- & Morris & Franco Central

CONTRACTOR

WILDCAT


_____ Ft. from N. Line

_____ Ft. from S. Line

_____ Ft. from E. Line

_____ Ft. from W. Line

SW SE NE

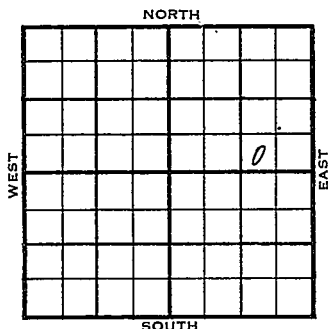

1956

ELEVATION

1139

REPORT

1-5

Cellar & Pits

1-25

Comm. 1-4-56

8 5/8" @ 124

Cored 3306-21 full rec.

5 1/2" @ 3354

47/ 3304-12, frac, wtr.

D & A

BL. 2248

Stal 2294

Layton 2703

KC 2863

Bart 3304

M. 3323

TD 3355'

ABANDONED

County Sumner Elev. _____
 Sec. 26 Twp. 33 Rge. 2E
 Company Rex & Morris & Franco Central
 Farm Name Holman No. 1

TOPS

DEPTH

LOG

DATUM

Loc. in Sec.

SW SE NE

Anh.

Tp.

H.

Tr.

Dg.

BL.

L.

K.C.

B.K.C.

Ce.

C.

M.

M.

K.

Mz.

Ma.

V.

S.

S.

A.

R.

Pe.

G.

T.D.

Geol.

Contr.

Pool

Wildcat

FIRST REPORT

JAN 5 '36

Date Comm.

Cellar & pits

County Summer Elev. 1139
 Sec. 26 Twp. 33 Rge. 2E
 Company Rex & Morris & Franco Central
 Farm Name Holman No. 1

TOPS	DEPTH	LOG	DATUM	Loc. in Sec.
Anh.				SW SE NE
Tr.				
H.				
Tr.				
Dg.				
BL.	<u>2248</u>		<u>1119</u>	
L. <u>Stall</u>	<u>2294</u>		<u>1155</u>	Geol.
K.C. <u>Stall</u>	<u>2703</u>		<u>1570.4</u>	
B.K.C. <u>MC</u>	<u>2863</u>		<u>1724</u>	Contr.
Ce. <u>Back</u>	<u>3304</u>		<u>2165</u>	
C.				
M.				
M.	<u>3323</u>		<u>2184</u>	Pool
K.				Wildcat
Mz.				
Mq.				
V.				
S.				
S.				
A.				
R.				
Pe.				
G.				
T.D.	<u>3355</u>			

Date Comm. 1-4-56 JAN 25 1956
8 5/8" @ 124 Cored 3306-21 full rec.
5 1/2" @ 3354 47/ 3304-12 frac wtr.

D & A