

KANSAS


Summer County

FORM 51 5M PETROL

Section 26 Township 33 Range 2E

Well No. 1 Holman

Company Eldorado Ref.

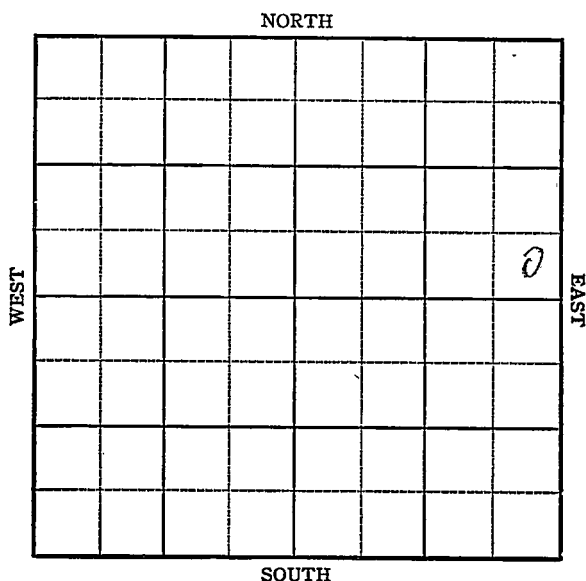

KANSAS

Summer

Sec. 26 Twp. 33 R. 2E

Well No. 1 Holman Farm
Eldorado Ref. Company

Miscellaneous


Ft. from N. Line

330 Ft. from S. Line

330 Ft. from E. Line

Ft. from W. Line

SE NE Elev. 1136

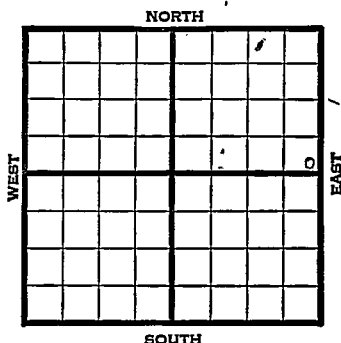

1945

REPORT

5/9

RUR

5/17

8" @ 138

Drlg. 857

5/24

KC

2870

Drlg. 3152

5/31

Bart 3295

TD 3326

5" @ 3292' RUST

6/8

" " " "

6/14

" - " - " - "

7/3

Miss. 3314

5" @ 3292'


TD 3367'

ABANDONED

Kans Pool Name MiscellaneousMap No. 1 Sec. 26 Twp. 33 R. 2EWell No. 1 HolmanEldorado Ref. CompanyFIRST REPORT Contractor

SE NE

SECTION PLAT

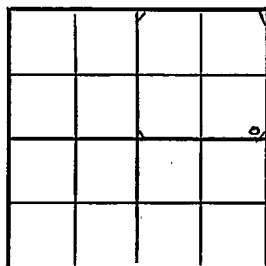 Ft. from N. Line330 Ft. from S. Line330 Ft. from E. Line Ft. from W. Line

Sumner

Location Rig up

Drilling and Remarks:

RUR

RECORD

Cased in., ft.Sand Gas Oil Total Depth

PRODUCTION

1st 24 hrs. Nat. 1st 24 hrs. after shot Gas Cu. Ft.Dry Hole Abandoned

Date

MAY 9 1945 19 S. J. LEWIS Scout

KANSAS

Kansas Pool Name MiscellaneousMap No. 1 Sec. 26 Twp. 33 R. 2EWell No. 1 Holman

Eldorado Ref. _____ Company _____

ABANDONED Contractor _____

SENE

E 1, 1/36
SECTION PLAT

			0

_____ Ft. from N. Line

330 Ft. from S. Line330 Ft. from E. Line

_____ Ft. from W. Line

Sumner County

Location _____

Rig up _____

Drilling and Remarks:

*Miss 3314**5" @ 3292***RECORD**

Cased _____ in., _____ ft.

Sand _____

Gas _____

Oil _____

Total Depth 3282**PRODUCTION**

1st 24 hrs. Nat. _____

1st 24 hrs. after shot _____

Gas _____ Cu. Ft.

Dry Hole _____

Abandoned _____

Date

JUL 3 1945 19S. J. LEWIS Scout