


Section 12 Township 12 Range 23 W

Well No. #1 Newcomer

Company Imperial Drlg.

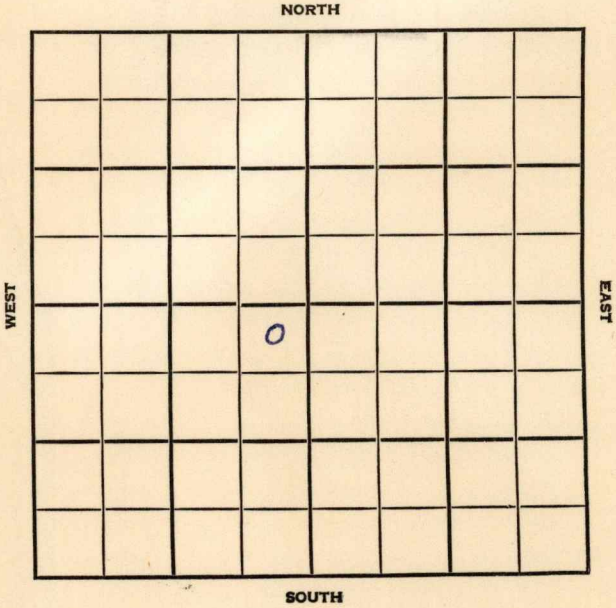

Trego

KANSAS

SEC. 12	TWP. 12	R. 23W
------------	------------	-----------

WELL NO.

#1 Newcomer

FARM

COMPANY

Imperial Drlg.

CONTRACTOR

Co. Tools

WILDCAT


_____ Ft. from N. Line

_____ Ft. from S. Line

_____ Ft. from E. Line

_____ Ft. from W. Line

NE NE SW

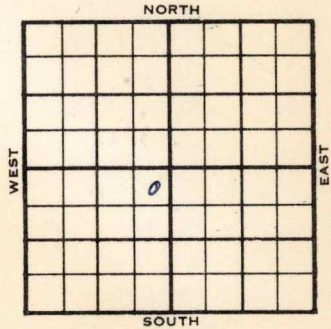

Stanolind - DHM

1956	ELEVATION 2410	REPORT
2-29	MIR	
4-4	Comm. 2-29-56 8 5/8" @ 205 w/150 DST 3621-41 op 2 hrs. rec. 120' hocm 1100/30" DST 3641-56 op 1 hr. rec. 570' ocs w, 1130/20" DST 3678-99 op 1 hr. rec. 420' oil, 30' muddy oil, 1150/25" DST 3733-46 op 1 hr. rec. 2340' oil, 60' msw, 1210# DST 3716-27 op 1 hr. gas in 55 min, rec. 1020' oil 1145/20" DST 3699-3710 op 1 hr. gas in 25 min, rec. 2100' oil, 1150/20" DST 3742-56 op 1 hr. 1800' gas, 120' ocm, 240' muddy oil, 1235/20" DST 3783-3809 op 1 hr. rec. 30' mud, 115/20" DST 3800-27 op 1 hr. rec. 25' mud, 65/20" DST 3843-66 op 1/2 hr. rec. 8' socm, 750/15" DST 3819-66 op 1/2 hr. rec. 20' mud, 645/20" 5 1/2" @ 4130	

1956

4-4 continued

CO to 4102, 26/ 3733-36

S/ 10 boph, 1 hr.

S/ 110 bo 11 hr.

FU 2700' oil, 8 hrs., 1700 A

S/ 70 boph 3 hrs.

Comp. BHB 3000 bopd

Anh. 1811

H. 3612

Tr. 3630

L. 3645

C. 4065

A. 4077

TD 4130

COMPLETED

County Trego Elev. _____
 Sec. 12 Twp. 12 Rge. 23W
 Company Imperial Drlg.
 Farm Name Newcomer No. 1

TOPS	DEPTH	LOG	DATUM	Loc. in Sec.								
Anh.				NE NE SW								
Tp.												
H.												
Tr.												
Dg.				Geol. _____								
Bl.												
L.				Contr. _____								
K.C.												
B.K.C.				Co. tools _____								
Ce.												
C.				Pool _____								
M.												
K.				Wildcat								
Mz.												
Me.				<table border="1"> <tr> <td></td> <td></td> </tr> <tr> <td>FIRST REPORT</td> <td></td> </tr> <tr> <td></td> <td></td> </tr> <tr> <td>FEB 29 '56</td> <td></td> </tr> </table>			FIRST REPORT				FEB 29 '56	
FIRST REPORT												
FEB 29 '56												
V.												
S.												
S.												
A.												
R.												
PE.												
G.												
T.D.												

Date Comm. Stanolind - DHM
M I R

(Large handwritten scribble)

Co.
Lse.
No.
Sec.
T.
R.

County Trego Elev. 2410
 Sec. 12 Twp. 12 Rge. 23W
 Company Imperial Drlg.
 Farm Name Newcomer No. 1

TOPS	DEPTH	LOG	DATUM	Loc. in Sec.																					
Anh.	<u>1811</u>			<u>NE NE SW</u>																					
TP.																									
H.	<u>3612</u>																								
Tr.	<u>3630</u>																								
Dg.																									
Bl.																									
L.	<u>3645</u>		<u>1235</u>	Geol.																					
K.C.				Contr.																					
B.K.C.				<u>Co. tools</u>																					
Ce.				Pool																					
C.	<u>4065</u>		<u>1655</u>	<u>Wildcat</u>																					
M.				<table border="1"> <tr> <td></td> <td></td> <td></td> </tr> <tr> <td></td> <td></td> <td></td> </tr> <tr> <td></td> <td></td> <td></td> </tr> <tr> <td></td> <td></td> <td></td> </tr> <tr> <td></td> <td></td> <td></td> </tr> <tr> <td></td> <td></td> <td></td> </tr> <tr> <td></td> <td></td> <td></td> </tr> </table>																					
Mz.																									
Mq.																									
V.																									
S.																									
S.																									
A.	<u>4077</u>		<u>1667</u>																						
R.																									
PE.																									
G.																									
TD.	<u>4130</u>			<u>APR 4 '56</u>																					

Date Comm. 2-29-56
8 5/8" @ 205/150 DST 3621-41 open 2 hr.
rec. 120' hocm 1100/30" DST 3641-56
open 1 hr. rec. 570' ocs w 1130/20"
DST 3678-99 open 1 hr. rec. 420' oil
30' muddy oil 1150/25" DST 3733-46
open 1 hr. rec. 2340' oil 60' ms w
1210# DST 3716-27 open 1 hr. gas
in 55 min. rec. 1020' oil 1145/20"

Co.
No.
Sec.
T.
R.

DST 3699-3710 open 1 hr. gas in 25 min.

rec. 2100' oil 1150/20" DST 3742-56

open 1 hr. 1800' gas 120' ocm

240' muddy oil 1235/20" DST 3783-3809

open 1 hr. rec. 30' mud 115/20"

DST 3800-27 open 1 hr. rec. 25' mud

65/20" DST 3843-66 open $\frac{1}{2}$ hr. rec.

8' socm 750/15" DST 3819-66 open $\frac{1}{2}$ hr.

rec. 20' mud 645/20" 5 $\frac{1}{2}$ " @ 4130 CO to

4102 26/ 3733-36 S/ 10 boph 1 hr.

S/ 110 bo 11 hr. FU 2700' oil 8 hr.

1700 A S/ 70 boph 3 hr.

Comp. BHB 3000 bopd

R. G.

APR 16 1956