

Section 23 Township 17 Range 11W

Well No. #1 Staatz

Company ~~Mallard et al~~ westanta -

Kraft-Prusa

NORTH

Greenland.

WEST

EAST

							0

SOUTH

KANSAS

Barton



Sec. 23 Twp. 17 R: 11W

Well No. #1. Staatz Farm
Westgate-Greenland.
~~Mallard et al~~ Company

Kraft-Prusa


330 Ft. from N. Line

_____ Ft. from S. Line

330 Ft. from E. Line

_____ Ft. from W. Line

NE SE

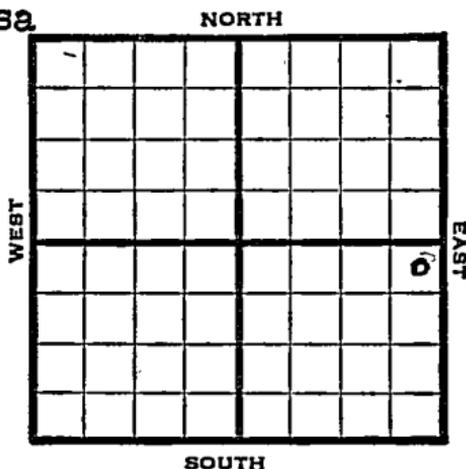

1947' Elev. 1855' REPORT

10/22 8" @ 225' WOC

10/29 R5ly. 2972'

11/12 Arbuckle 3313'
5" @ 3363'
Perf.
Total Depth 3363'

ABANDONED

Map No. _____ Sec. 23 Twp. 17 R. 11W

Well No. 1 Staatz

Mallard etal. Company

FIRST REPORT Contractor

NE SE

SECTION PLAT

330 Ft. from N. Line

_____ Ft. from S. Line

330 Ft. from E. Line

_____ Ft. from W. Line

Barton County

Location _____

RECORD

Rig up _____

Drilling and Remarks:

00

8" @ 225' WOC

Cased _____ in., _____ ft.

Sand _____

Gas _____

Oil _____

Total Depth _____

PRODUCTION

1st 24 hrs. Nat. _____

1st 24 hrs. after shot _____

Gas _____ Cu. Ft.

Dry Hole _____

Abandoned _____

Date

OCT 22 1947 19

S. I. LEWIS Scout

Map No. 55 Sec. 23 Twp. 17 R. 11W

Well No. 1 Staatz

Westgate-Greenland Company

CORRECTION Contractor

NE SE

SECTION PLAT

330 Ft. from N. Line

_____ Ft. from S. Line

330 Ft. from E. Line

_____ Ft. from W. Line

			o

Barton County

Location _____

Rig up _____

Drilling and Remarks:

Reported

Mallard Drlg.

RECORD

Cased _____ in, _____ ft.

Sand _____

Gas _____

Oil _____

Total Depth _____

PRODUCTION

1st 24 hrs. Nat. _____

1st 24 hrs. after shot _____

Gas _____ Cu. Ft.

Dry Hole _____

Abandoned _____

Date

NOV 12 1947 19 .

S. J. LEWIS Scout

Map No. 55 Sec. 23 Twp. 17 R. 11W

Well No. 1 Staatz

Westgate-Greenland Company

ABANDONED

Contractor

NE SE

E 11855

SECTION PLAT'

330 Ft. from N. Line

			o

_____ Ft. from S. Line

330 Ft. from E. Line

_____ Ft. from W. Line

Barton County

Location _____

RECORD

Rig up _____

Cased _____ in., _____ ft.

Drilling and Remarks:

Sand _____

Gas _____

Oil _____

Total Depth 502.8

*Cor 42813
5" @ 3063
Prof.*

PRODUCTION

1st 24 hrs. Nat. _____

1st 24 hrs. after shot _____

Gas _____ Cu. Ft.

Dry Hole _____

Abandoned _____

Date

NOV 12 1947

19

S. J. LEWIS

Scout