


Section 23 Township 17 Range 11W

Well No. 1 Staatz "A"

Company Sharon Drlg.

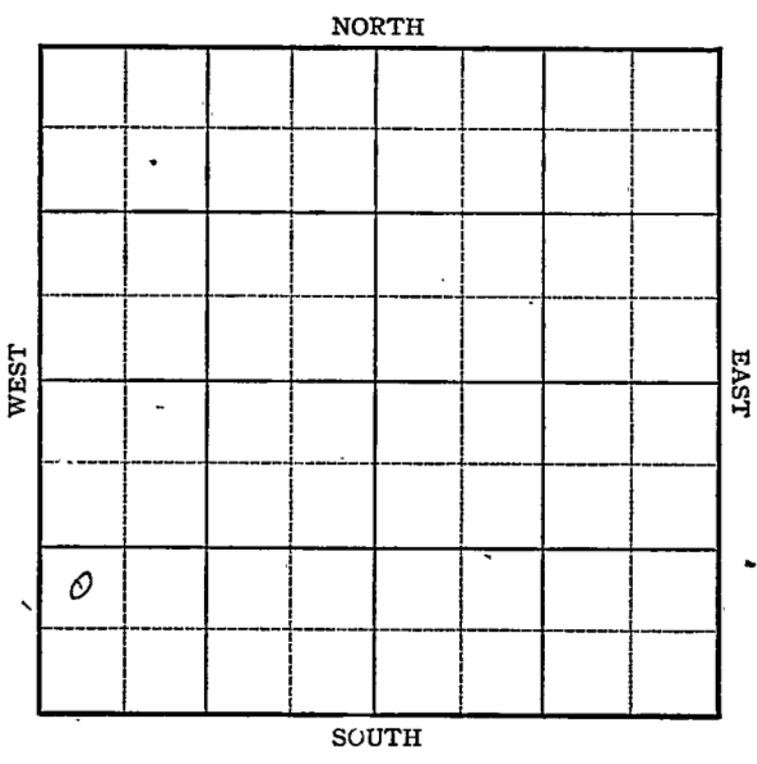

Sec. 23 Twp. 17 R. 11-W

Well No: #1 Staatz "A" Farm


Sharon Drlg. Company

 Ft. from N. Line

990 Ft. from S. Line

 Ft. from E. Line

330 Ft. from W. Line

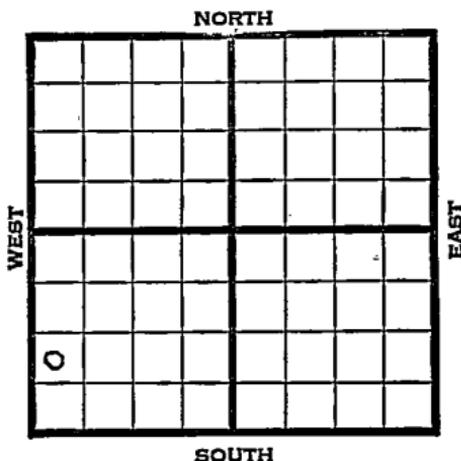

NW SW SW

1945 Elev. 1840 REPORT

| | |
|------|--|
| 8/1 | RUR |
| 8/8 | 10" @ 200 Drlg. 1540 |
| 8/15 | Drlg. 3096 |
| 8/22 | Lans 3032 Arb. 3297 TD 3301' 5" @ 3297 RUST |
| 8/29 | Pump 2 oil per hr. |
| 9/5 | " " " " |
| 9/12 | Arb. 3297 5" @ 3297 TD 3301' Pump 25 Pot. Grav. 41.9 |

COMPLETED

KANSAS KansasPool Name Kraft-PrusaMap No. 55 Sec. 23 Twp. 17 R. 11WWell No. 1 Staatz "A"

Shar on Drlg. _____ Company _____

FIRST REPORT

Contractor _____

NW SW SW

SECTION PLAT

_____ Ft. from N. Line

990 Ft. from S. Line

_____ Ft. from E. Line

330 Ft. from W. Line

| | | | |
|---|--|--|--|
| | | | |
| | | | |
| | | | |
| 0 | | | |

*T 1717*Barton County

Location _____

Rig up _____

Drilling and Remarks:

RUR

RECORD

Cased _____ in., _____ ft.

Sand _____

Gas _____

Oil _____

Total Depth _____

PRODUCTION

1st 24 hrs. Nat. _____

1st 24 hrs. after shot _____

Gas _____ Cu. Ft.

Dry Hole _____

Abandoned _____

Date

AUG 1 1945 19S. J. LEWIS Scout

KANSAS

Kansas

Pool Name

Kraft-Prusa

Map No. 55 Sec. 23 Twp. 17 R. 11WWell No. 1 Staatz "A"

Sharon Drlg.

Company

COMPLETED

Contractor

NW SW SW

E. 1840
SECTION PLAT

| | | | |
|---|--|--|--|
| | | | |
| | | | |
| | | | |
| 0 | | | |

Ft. from N. Line

990 Ft. from S. Line

Ft. from E. Line

330 Ft. from W. Line

Barton County

Location _____

Rig up _____

Drilling and Remarks:

*CR 83297**5" CR 3297**Pump 25 ft**H. E. G.*

RECORD

Cased _____ in., _____ ft.

Sand _____

Gas _____

Oil _____

Total Depth 330

PRODUCTION

1st 24 hrs. Nat. _____

1st 24 hrs. after shot _____

Gas _____ Cu. Ft.

Dry Hole _____

Abandoned _____

Date

SEP 12 1945

19

S. J. LEWIS

Scout