


Trego

KANSAS

SECTION 12 TOWNSHIP 12 RANGE 23W

WELL NO. #1 Rasek "A"

COMPANY Phillips Petr.

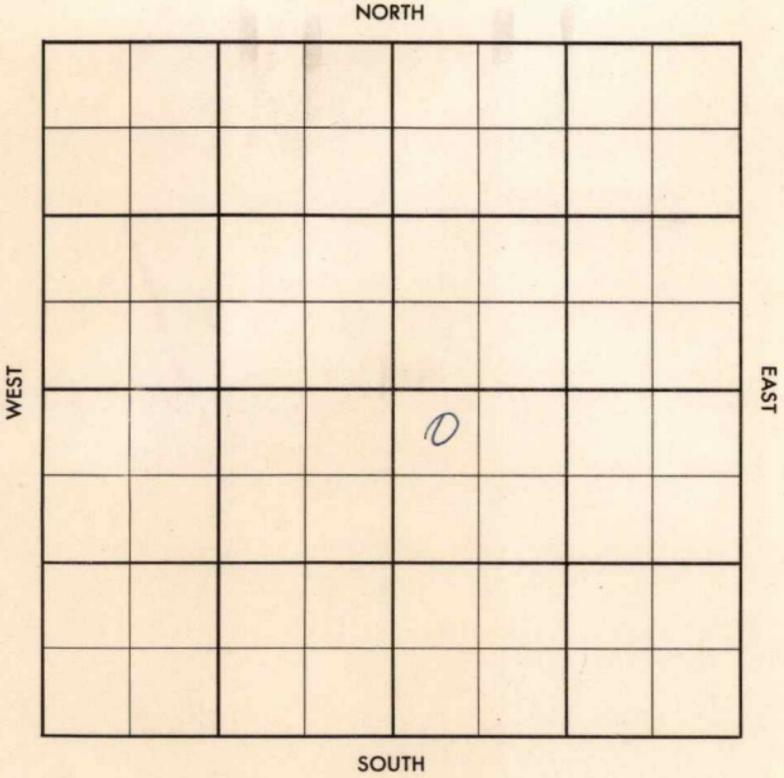

County Trego Elev. _____
 Sec. 12 Twp. 12 Rge. 23W
 Company Phillips Petroleum
 Farm Name Rasek "A" No. 1

TOPS	DEPTH	LOG	DATUM	Loc. in Sec.
Anh.				NW NW SE
TP.				
H.	3605			
Tr.	3623			
Dg.				
Bl.				
L.	3638			
K.C.	3787			Geol.
B.K.C.	3879			Contr.
Ce.				Co. tools
C.				
M.				Pool
K.				Newcomer
Mz.				
Me.				
V.				
S.				
S.				
A.				
R.				
PE.				
G.				
TD.	3910			

COMPLETE
 JUN 13 '56

Date Comm. 4-19-56

8" @ 325/195 drlg. 2740 MAY 2 '56 5 1/2 @
 3909/120 MAY 9 '56 CO 3886 20/
 3821-26 ϕ 1/2 GW (N.S.) (1/2) not st
 8/3781-83 ϕ 6 GW (50) 1hr
 1 1/2 ϕ 95 B0 + 31 BW in 3 hrs
 PB 3770 12/3738-41 8/3742-46
 ϕ 75 B0 + 7 BW in 2 3/4 hrs
 t stg. MAY 16 '56 CO 3886 1/2 PB
 3735 20/3723-28 ϕ 76 B0 +

Co.
 Lse.
 No.
 Sec.
 T
 R

12-12-23W NW NWSE

8 BW 2 hrs 12/3713-16 8

158 B0 + 25 BW 4 hrs P

225 B0 + 49 BW 23 hrs

MAY 23 '56

MAY 29 '56

JUN 6 '56

JUN 13 '56

Phy Pat 891 B0 + 281 BW

County Trego Elev. _____
 Sec. 12 Twp. 12 Rge. 23W
 Company Phillips Petroleum
 Farm Name Raser No. 1

TOPS	DEPTH	LOG	DATUM	Loc. in Sec.
Anh.				NW NW SE
Tp.				
H.				
Tr.				
Dg.				
Bl.				
L.				Geol. _____
K.C.				Contr. _____
B.K.C.				
Ce.				Co. tools
C.				
M.				Pool
M.				Newcomer
K.				
Mz.				
Me.				
V.				
S.				
S.				
A				FIRST REPORT
R.				
Pe.				0
G.				
T.D.				APR 25 '56

Date Comm. 4-19-56
8" @ 325/195 drlg. 2740

MADE BY S YAM

[Handwritten signature]

Co.
Lse.
No.
Sec.
T.
R.