

KANSAS

Barton


FORM 51 5M 4-41 PETROL

Section 23 Township 17 Range 11-W

Well No. #2 Disque "B"

Company Auto Ordinance

NORTH Kraft Prusa Pool

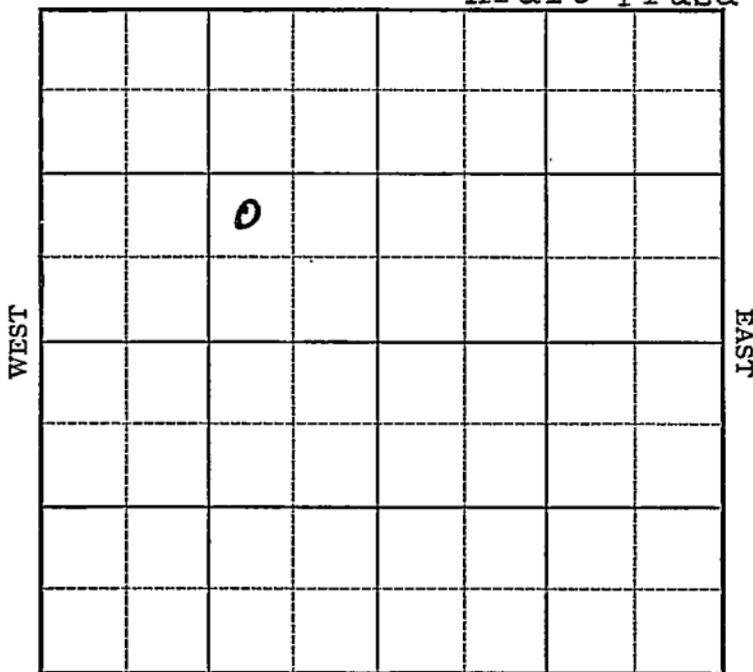

SOUTH

Sec. 23 Twp. 17 R. 11-W

Well No. #2 Disque "B" Farm _____

Auto Ordinance Company _____

(Kraft-Prusa)


_____ Ft. from N. Line

990 Ft. from S. Line

990 Ft. from E. Line

_____ Ft. from W. Line

Elev. 1866

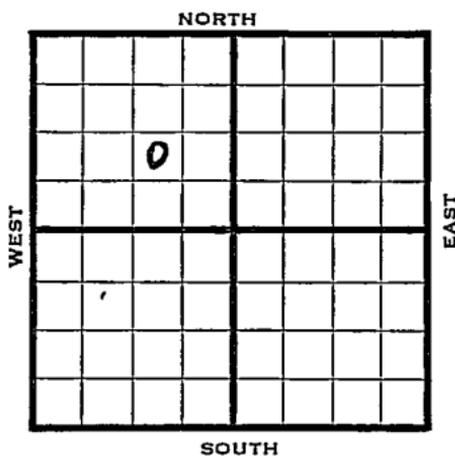

1942

REPORT

6/24

Rotary.

7/1

9" - 165' Drlg. 1374'

7/8

Drlg. 2870'

7/15

Cong. 3328'

T.D. 3351'

No shows.

ABANDONED

Barton KANSAS

Map No. 5-5 Sec. 23 Twp. 17 R. 11W

Well No. 2 Disque "B"

Auto Ordinance Company

FIRST REPORT Contractor

NW SE NW

SECTION PLAT

_____ Ft. from N. Line

990 Ft. from S. Line

990 Ft. from E. Line

_____ Ft. from W. Line

	o		

KRAFT PRUSA POOL

Location _____

Rig up _____

Drilling and Remarks:

Rotary

RECORD

Cased _____ in., _____ ft.

Sand _____

Gas _____

Oil _____

Total Depth _____

PRODUCTION

1st 24 hrs. Nat. _____

1st 24 hrs. after shot _____

Gas _____ Cu. Ft.

Dry Hole _____

Abandoned _____

Date

JUN 24 1942

19

S. J. LEWIS

Scout

Map No. 55 Sec. 23 Twp. 17 R. 11W

Well No. 2 Disque "B"

Auto Ordnance Company

ABANDONED Contractor

NW SE NW

SECTION PLAT

_____ Ft. from N. Line

990 Ft. from S. Line

990 Ft. from E. Line

_____ Ft. from W. Line

	0		

KRAFT PRUSA POOL

Location _____

Rig up _____

Drilling and Remarks:

Cong 3328
Noe howe

RECORD

Cased _____ in., _____ ft.

Sand _____

Gas _____

Oil _____

Total Depth 3257

PRODUCTION

1st 24 hrs. Nat. _____

1st 24 hrs. after shot _____

Gas _____ Cu. Ft.

Dry Hole _____

Abandoned _____

Date

JUL 15 1942 19

S. J. LEWIS Scout