

FORM 51


Barton

KANSAS

Section 23 Township 17 Range 11W

Well No. #3 Disque "A"

Company N C R A

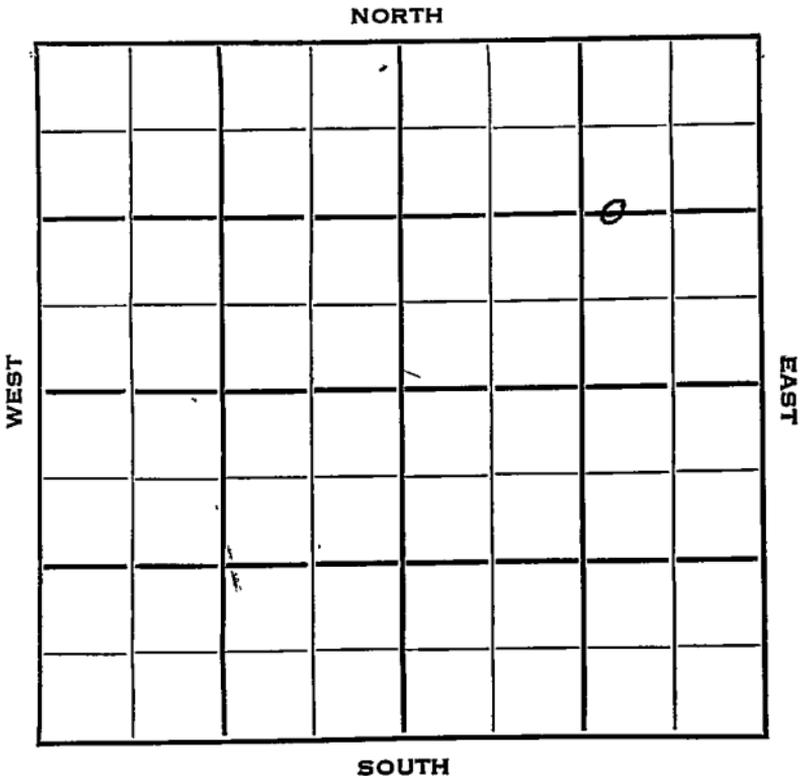

Barton KANSAS ✓

Sec. 23 Twp. 17 R. 11 WWell No. # 3 Disque "A" Farm _____Pan-Kar

Company _____

Contractor _____


1320 Ft. from N. Line

_____ Ft. from S. Line

990 Ft. from E. Line

_____ Ft. from W. Line

C W/2 E/2 NE

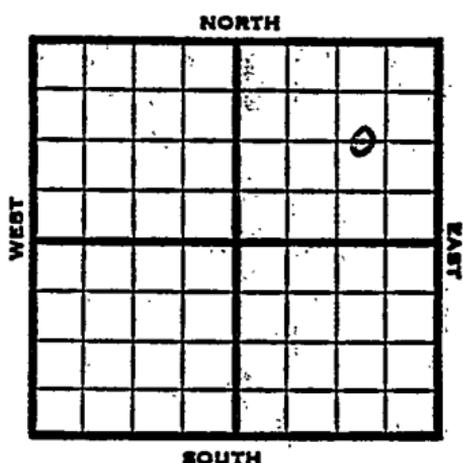

1953

Elev. 1864 REPORT

2/4 Spud 2-1-53
8" @ 320 WOC


2/12 Drlg. 2900'

2/18 Spudding Date 2/1/53
D&A TD 3375
8" @ 320 Top 2677 Heeb; 2926
Tor. 2943 Doug. 2957 Br. Lime 3031
Lans. 3053 Arb. 3317 DST 3320-29
op n 2 hr. Rec. 20' mud 215 #
DST 3321-32 open 2 hr. Rec. 12'
Oil 23' mud 945# TD 3375

D&A

ABANDONED

County Barton State Kansas
 Sec. 23 (Blk. 17) (Sur. 11W) (Twp. 17) (Rge. 11W) Map No.
 Operator N C R A
 Well No. 3 Farm Disque "A"
 Elev. 1864 Location C W $\frac{1}{2}$ E $\frac{1}{2}$ NE

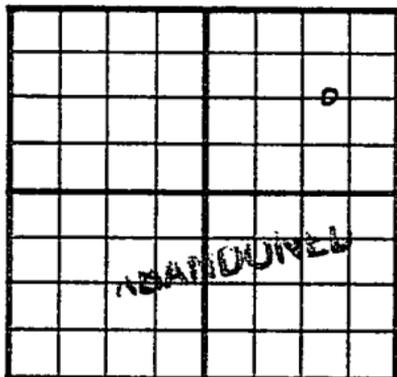

1320 Ft. From N Line NE
990 Ft. From E Line Quarter
 1st. Report
 Completion FEB 18 1953
 Remarks
Pam-Kar - Contr.
 Spudding Date 2-1-53

Drilg. Data D & A TD 3375
8" @ 320 Top. 2677 Heeb. 2926
Tor. 2943 Doug. 2957 Br. lime 3031
Lens. 3053 Arb. 3317 DST 3320-29
open 2 hr. Rec. 20' mud 215#
DST 3321-32 open 2 hr. Rec. 12' oil
23' mud 945# TD 3375

D & A

J. G. McGEHEE