
Trego

KANSAS

SECTION 12 TOWNSHIP 12 RANGE 23W

WELL NO. #3 Newcomer "A"

COMPANY Imperial Petr.

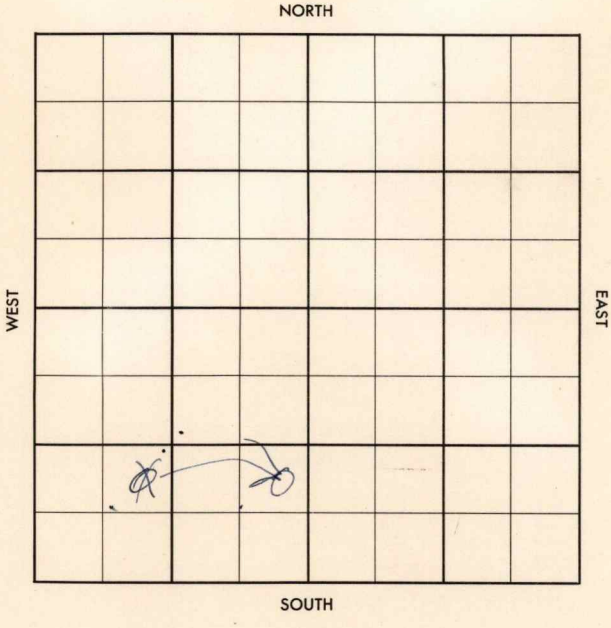

FORM 504-3 SUNRAY

Trego KANSAS

SEC.	TWP.	R.
12	12	23W

WELL NO. #3 Newcomer "A" FARM

COMPANY Imperial Petr.

CONTRACTOR Co. Tools

Newcomer


_____ Ft. from N. Line

_____ Ft. from S. Line

_____ Ft. from E. Line

_____ Ft. from W. Line

NE ~~SW~~ SW
SE

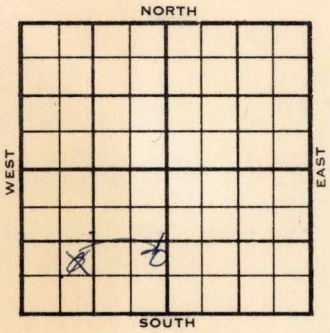

1956 ELEVATION 2404 REPORT

5-16
6-27

Location
Comm. 5-15-56
8 5/8" @ 197/175
DST 3681-3700 1 hr 930' Gip rec 30'
SOCM ≠ 60' HOCM ≠ 60' oil 1140/20"
5½ @ 3852 co 17/3810-13
Ø 1 BOPH 120/W 1500 A
Ø 1 BOPH PB 3750 16/3723-26
Ø 10 BOPH/8 hrs 500 A
Ø 20 BOPH/8 hrs Pop.
P. BH bomb 746 Bopd no/wtr grav. 38°
Anh. 1812; H. 3616; L. 3652;
TD. 3852

COMPLETED

DX-78

CORRECTION

FORM 513 SUNRAY

County Trego Elev. 2404

Sec. 12 Twp. 12 Rge. 23W

Company Imperial Pet.

Farm Name Newcomer "A" No. 3

TOPS	DEPTH	LOG	DATUM
Anh.	1812		
Tp.			
H.	3616		
Tr.			
Dg.			
B.L.			
L.	3652		
K.C.			
B.K.C.			
Ce.			
C.			
M.			
M.			
K.			
Mz.			
Mo.			
V.			
S.			
S.			
A			
R.			
P€.			
G.			
TD	3852		

Loc. in Sec. NE ~~SW~~ SW SE

Geol.

Contr. Co. tools

Pool Newcomer

COMPLETE

Date Comm. JUN 27 '56

Location MAY 23 '56 5-15-56 8 5/8

197/175 @ 3560 MAY 29 '56 DST

3681-3700 1hr 930' GIP rec.

30' SOCM +60' HOCM +60' OIL

1140/20 m 5½ @ 3852 Co 17/

3810-13 1/2 & 1 BOPH no GW

JUN 6 '56 1500 A & 180PH PB 3750

16/3723-26 & 100PH 18hrs

500 A & 20 BOPH 18hrs POP

FORM 513-1 SUNRAY

NE SE SW

JUN 13 '56 JUN 20 '56 JUN 27 '56 P, DH Bomb

746 Bopd no wtr grav 38°

FORM 513 SUNRAY

County Trego Elev.

Sec. 12 Twp. 12 Rge. 23W

Company Imperial Pet.

Farm Name Newcomer "A" No. 3

TOPS	DEPTH	LOG	DATUM
Anh.			
Tp.			
H.			
Tr.			
Dg.			
B.L.			
L.			
K.C.			
B.K.C.			
Ce.			
C.			
M.			
M.			
K.			
Mz.			
Mo.			
V.			
S.			
S.			
A			
R.			
P€.			
G.			
T.D.			

Loc. in Sec. NE SW SW

Geol.

Contr. Co. tools

Pool Newcomer

FIRST REPORT

MAY 16 [illegible]

Date Comm.

Location

MAY 25 1938

R. G.

Co. Lse. No. Sec. T. R.