

SECTION 29 TOWNSHIP 33S RANGE 2E

WELL NO. #1 Totten

COMPANY Aladdin

NORTH SE NE SW

11

WEST


EAST

			0				

SOUTH

CO. Sumner ELEV. _____
SEC. 29 TWP. 33 RGE. 2E
COMPANY Aladdin NO. 1

FIRST REPORT

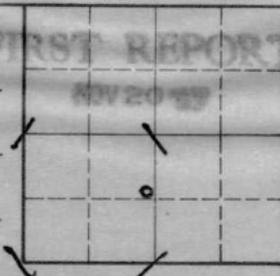

FARM Totten
LOC. SE NE SW

GEOL. _____

CONTR. Shawver-Armour #2

POOL Rutter Ext.

SPUD _____

MIRT

29

CO.
LSE.
NO.
SEC.
TWP.
RGE.

Corrected Info.


~~29~~

S-513-B

County Sumner Elev. 1180
 Sec. 29 Twp. 33 Rge. 2E
 Company Aladdin
 Farm Name Totten No. 1

TOPS	DEPTH	LOG	DATUM
Anh.			
Tp.			
H.			
Tr.			
Dg.			
B.L.			
L.			
K.C.			
B.K.C.			
Ce.			
C.			
M.			
M.			
K.			
Mz.			
Mq.			
V.			
S.			
S.			
A.			
R.			
Pf.			
G.			
T.D.			

Loc. in Sec. SE NE SW
 Geol. _____
 Contr. _____
 Pool _____

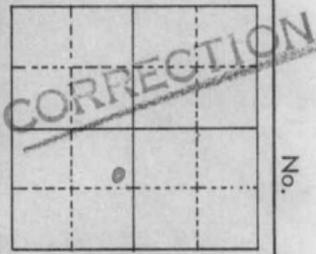

Date Comm. CORRECTED INFORMATION
CORRECT PERFORATIONS 16/ 3556-60
This is not a new pay zone. Still
producing from the Arbuckle

Co.
Lse.
No.
Sec.
T.
R.

